IREDELL COUNTY HEALTH DEPARTMENT

STATESVILLE 704-878-5305 MOORESVILLE 704-664-5281

IMPROVEMENT PERMIT / AUTHORIZATION TO CONSTRUCT / OPERATION PERMIT / EXISTING SYSTEM INSPECTION

PERMIT# 090238 PIN# 4603746668 DATE June 29, 2000

OWNER OR CONTRACTOR Robert L. Collins PHONE: Business 664-2321 Home

ADDRESS 112 Revere Dr. Mooresville, N.C. 28117

LOCATION 115N TL Linneys Mill Rd 2.8 miles TR Hillsdale ~1/4 mile on left ~350' off Road

SUBDIVISION Brushy Mtn Acres BLOCK / SECTION LOT 3 LOT AREA 7.29 Ac SITE CLASS PS DESIGN FLOW 360 gpd L.T.A.R. .03+

Septic Tank: 1000 Gallons; STB 0820 Date 7-29-00
Pump Tank: Gallons; PT Date
Pump Make: Model Serial No.
Nitrification Field: No Fields 1 Square Feet 1200 Linear Feet 400
No Lines 4@100' Trench Width 36" Max Trench Bottom Depth 36" Gravel Depth 12"

☑ New System ☐ Repair System Type: I II III IV V VI
System Description: Gravity conventional
Repair System Description: Same
Maintenance Agreement Required: ☐ Yes ☑ No
☐ Slab ☑ Crawl Space ☐ Basement w/plumbing ☐ Basement wo/plumbing

☑ House/Mod. Home No. Bedrooms 3
☐ Mobile Home No. Bathrooms 2
☐ Business No. Employees
☐ Other


Water Supply: ☑ Individual ☐ Public ☐ Community

Comments:/Conditions: PF

Comments:/Conditions: SEPTIC TANK WITH RISERS INSTALLED USING "TUF-TITE" FILTER

Not to scale

INITIAL SITE SKETCH

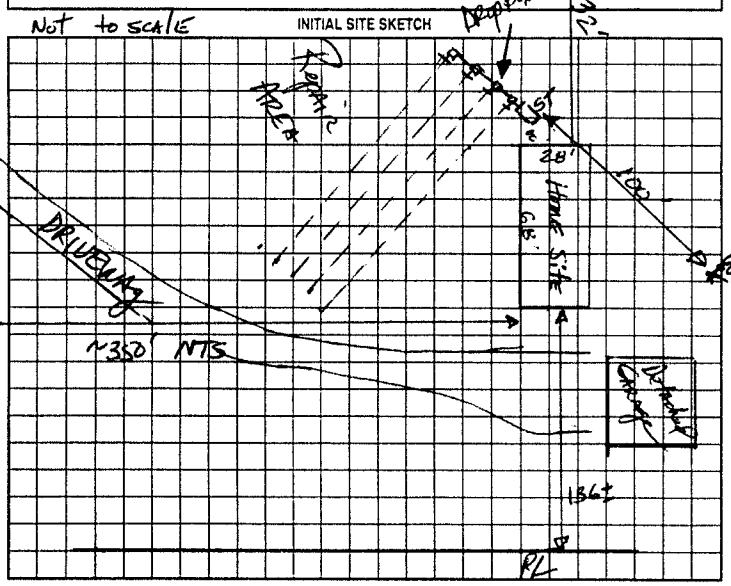

AS BUILT SKETCH

SYSTEM INSTALLED ACCORDING TO INITAL SITE SKETCH

Permit can be suspended or revoked if any false information is supplied toward securing the permit/any unauthorized changes are made to the site/any unauthorized changes are made in the installation of the system. Improvement Permit with plat valid without expiration. Improvement Permit with site plan valid for sixty months. Authorization to Construct is valid for a period equal to that of Improvement Permit – not to exceed sixty months.

Signed: [signature] date

Improvement Permit by: [signature], RS date June 29, 2000

Authorization to Construct by: [signature], RS date June 29, 2000

Installed by: KENNY MADISON

Operation Permit by: STEVE HENDRICK date 9-15-00

Existing System Inspection by: date

HEALTH DEPT. COPY: WHITE OWNER COPY (FINAL): YELLOW OWNER COPY (INITIAL): PINK