LEROY TEMPLETON

IREDELL COUNTY HEALTH DEPARTMENT

PAID $130.00

STATESVILLE 704-878-5305 (01) MOORESVILLE 704-664-5281

IMPROVEMENT PERMIT / AUTHORIZATION TO CONSTRUCT / OPERATION PERMIT / EXISTING SYSTEM INSPECTION

PERMIT# 11343 PIN# 4803-74-9455 DATE 7-19-03

OWNER OR CONTRACTOR LEROY B. HEBBARD, JR. PHONE: Business % 704-892-6333 Home 704-995-3331

ADDRESS 790 BAYTREE DRIVE, TITUSVILLE, FL 32780

LOCATION NC 115 NORTH, TL LINNEY'S MILL ROAD, TR HILLSDALE ROAD, 3RD TRACT ON LEFT

SUBDIVISION BRUSHY MTN AC. BLOCK / SECTION ____ LOT 4 LOT AREA 6.80 ACRES SITE CLASS. PS DESIGN FLOW 360 L.T.A.R. 0.30 GPD/FT²

Septic Tank: 1000 Gallons; STB 825 Date 7-15-04
Pump Tank: ____ Gallons; PT ____ Date ____
Pump Make: ____ Model ____ Serial No. ____
Nitrification Field: No Fields 1 Square Feet 1200 Linear Feet ~~400~~ 300
No Lines ~~Four~~ 3 Trench Width 36" Max Trench Bottom Depth (30") Gravel Depth 12"

☑ New System ☐ Repair System Type: I II III 125% RED
System Description: ~~CONVENTIONAL~~, GRAVITY
Repair System Description: CONVENTIONAL, GRAVITY
Maintenance Agreement Required: ☐ Yes ☑ No


☑ House/Mod. Home No. Bedrooms 3
☐ Mobile Home No. Bathrooms 2
☐ Business No. Employees ____
☐ Other ____

☐ Slab ☑ Crawl Space ☐ Basement w/plumbing ☐ Basement wo/plumbing

Water Supply:
☑ Individual
☐ Public
☐ Community
WELL


Comments:/Conditions: KEEP SYSTEM MINIMUM 100 FEET FROM WELL

INITIAL SITE SKETCH

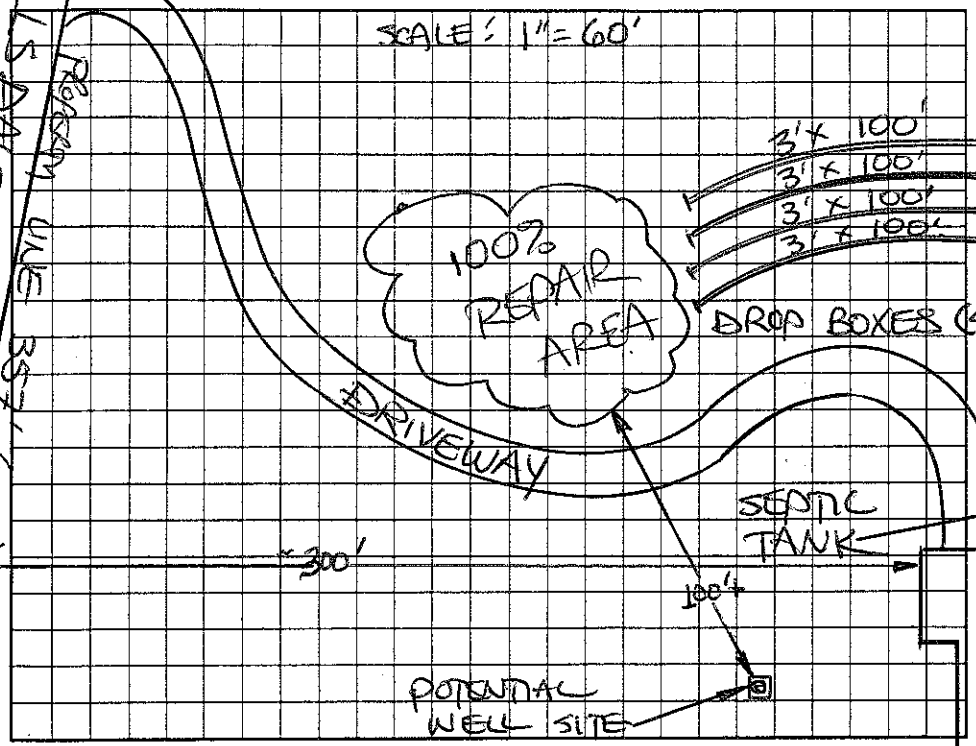

Comments:/Conditions: SEPTIC TANK WITH MARKER INSTALLED USING "POLY LOK" FILTER
25% REDUCTION SYSTEM INSTALLED USING 30 HDR SECTIONS

AS BUILT SKETCH

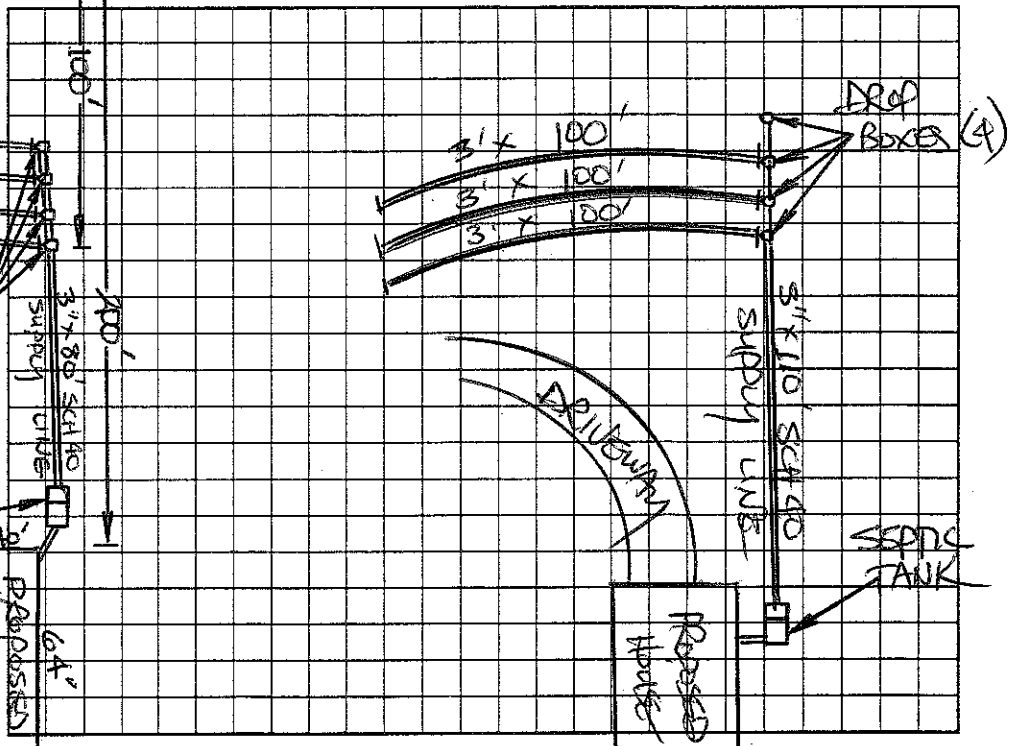

Permit can be suspended or revoked if any false information is supplied toward securing the permit/any unauthorized changes are made to the site/any unauthorized changes are made in the installation of the system. Improvement Permit with plat valid without expiration. Improvement Permit with site plan valid for sixty months. Authorization to Construct is valid for a period equal to that of Improvement Permit – not to exceed sixty months.

Signed: Julie A Byrd date 7-24-03 Installed by: ERIC EILER

Improvement Permit by: STEVE HEDRICK date 7-19-03 Operation Permit by: STEVE HEDRICK date 10-20-04

Authorization to Construct by: STEVE HEDRICK date 7-19-03 Existing System Inspection by: ____ date ____

HEALTH DEPT. COPY: WHITE OWNER COPY (FINAL): YELLOW OWNER COPY (INITIAL): PINK