IREDELL COUNTY HEALTH DEPARTMENT

STATESVILLE 704-878-5305 MOORESVILLE 704-664-5281

IMPROVEMENT PERMIT / AUTHORIZATION TO CONSTRUCT / OPERATION PERMIT / EXISTING SYSTEM INSPECTION

PERMIT # 154275 PIN # 4803-75-1133 DATE 5 FEBRUARY 09

OWNER or APPLICANT James & Tammy Setzer PHONE: Business 704-650-3728 Home: 336-818-0030

OWNER or APPLICANT ADDRESS 1521 Cedar Lane Wilkesboro, N.C.

LOCATION / DIRECTIONS 115N TL Linney's Mill Rd. TR Hillsdale Prop. on Left.

SUBDIVISION Brushy Mtn. Acres BLOCK / SECTION LOT # 1 LOT AREA 8.49Ac. DESIGN FLOW 360 g/d L.T.A.R. 0.3 g/179 g/d

Septic Tank 1000 Gallons: STB 760 Date 4-1-09

Pump Tank Gallons: P.T Date

Pump Make Model Serial #

Nitrification Field No Fields 1 No Lines 3 Linear Feet ~~300~~ 400

Trench Width 36" Max. Trench Bottom Depth 36" Gravel Depth 12"

☑ New System ☐ Repair ☐ Expansion System Type I II IV V VI

System Description: ~~25%~~ Reduction Conventional

Repair System Description: 25% Reduction

Maintenance Agreement Required ☐ YES ☑ NO

☑ GRAVITY ☐ PRESSURE

☑ Residence No. Bedrooms 3

☐ Business No. Persons

☐ Other No. Employees

☐ Slab ☑ Crawl Space

☐ Basement w/plumbing ☐ Basement w/o plumbing

Water Supply: ☑ Private ☐ Public ☐ Community

Comments / Conditions


Honor all setback requirements.

Comments / Conditions Red tuff tile fill.

INITIAL SITE SKETCH

* Please see attached sketch plan

AS BUILT SKETCH

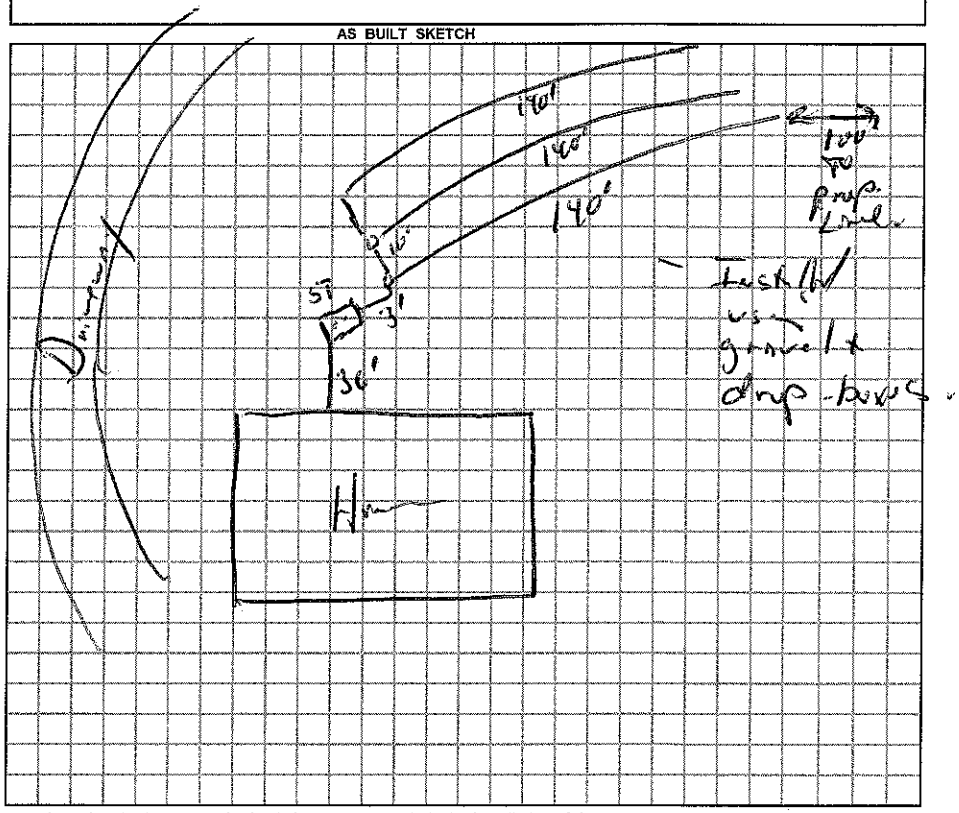

Permit can be suspended or revoked if any false information is supplied toward securing the permit / any unauthorized changes are made to the site / any unauthorized changes are made in the installation of the system.

☐ *IMPROVEMENT PERMIT w / plat valid without expiration.* ☑ *IMPROVEMENT PERMIT w / site plan valid for 60 mos.* ☑ *AUTHORIZATION TO CONSTRUCT valid for period equal to IMPROVEMENT PERMIT-not to exceed 60 mo.*

Owner / Applicant Signature: Date 2/10/09

Improvement Permit by: , R.S. Date 4 Feb 09

Authorization to Construct by: , R.S. Date 4 Feb. 09

YOU SHOULD CONTACT A LOCATOR SERVICE PRIOR TO ANY EXCAVATION.

Installed by: Tammy Nixon

Operation Permit by: , R.S. Date: 7 Oct. 09

Existing System Inspected by: Date:

WHITE COPY Environmental Health YELLOW COPY (Final) Owner / Applicant PINK COPY (Initial) Owner / Applicant