IREDELL COUNTY HEALTH DEPARTMENT

STATESVILLE 704-878-5305 (CL) MOORESVILLE 704-664-5281 (CL)

IMPROVEMENT PERMIT / AUTHORIZATION TO CONSTRUCT / OPERATION PERMIT / EXISTING SYSTEM INSPECTION

PERMIT# 107814 PIN# 4803-77-5720 DATE 8-5-02

OWNER OR CONTRACTOR GARY GORE PHONE Business 704-872-2411 Home 704-592-4824

ADDRESS 297 OAK HOLLOW ROAD, UNION GROVE, NC 28689

LOCATION NC 115 N, TL LINNEY'S MILL RD, TR OAK HOLLOW, TL HILLSDALE, TR STONEY CREEK, ~800' on (R)

SUBDIVISION _____ BLOCK / SECTION _____ LOT _____ LOT AREA 2.16 ACRES SITE CLASS PS DESIGN FLOW 360 L T A R / 0.30 GAL/FT²

Septic Tank: 1000 Gallons: STB 825 Date 6-2-02
Pump Tank: _____ Gallons: PT _____ Date _____
Pump Make: _____ Model _____ Serial No _____
Nitrification Field: No Fields 1 Square Feet 1200 Linear Feet 400
No Lines FOUR Trench Width 36" Max Trench Bottom Depth 36" Gravel Depth 12"

~~New System~~ Repair System Type: (I) II III IV V
System Description: CONVENTIONAL, GRAVITY
Repair System Description: CONV. GRAVITY
Maintenance Agreement Required: Yes ~~No~~

~~House/Mod Home~~ No. Bedrooms 3
~~Mobile Home~~ No. Bathrooms 2
Business No. Employees _____
Other _____
Slab Crawl Space Basement w/plumbing Basement wo/plumbing


Water Supply: ☑ Individual ☐ Public ☐ Community
WELL

Comments/Conditions:

Comments/Conditions: SEPTIC TANK WITH MARKER INSTALLED USING "POLYLOK" FILTER

SCALE: 1" = 50'

INITIAL SITE SKETCH

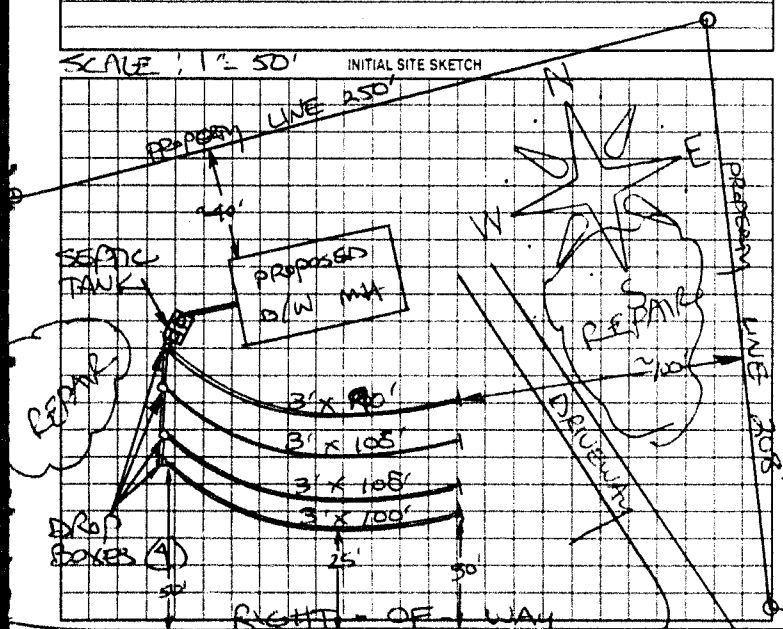

AS BUILT SKETCH

SYSTEM INSTALLED ACCORDING TO INITIAL SITE SKETCH

PROPERTY LINE 577'

Permit can be suspended or revoked if any false information is supplied toward securing the permit, any unauthorized changes are made to the site, or unauthorized changes are made in the installation of the system. Improvement Permit with plat valid without expiration. Improvement Permit with site plan valid for sixty months. Authorization to Construct is valid for a period equal to Improvement Permit - not to exceed sixty months

Signed: _____ date 8-5-02 Installed by WAYNE ELLER

Improvement Permit by: STEVE HEDRICK date 8-5-02 Operation Permit by: STEVE HEDRICK date 8-26-02

Authorization to Construct by: STEVE HEDRICK date 8-5-02 Existing System Inspection by: _____ date _____

HEALTH DEPT COPY WHITE OWNER COPY (FINAL) YELLOW OWNER COPY (INITIAL) PINK