IREDELL COUNTY HEALTH DEPARTMENT

STATESVILLE 704-878-5305 MOORESVILLE 704-664-5281

IMPROVEMENT PERMIT / AUTHORIZATION TO CONSTRUCT / OPERATION PERMIT / EXISTING SYSTEM INSPECTION

PERMIT# 084385 PIN# 4803 78 3475 DATE 11-16-99

OWNER OR CONTRACTOR MARIE McPHERSON PHONE: Business 876-3727 Home

ADDRESS 156 FINK ROAD, STATESVILLE, NC 28625

LOCATION NC 115 N, TL LINNEY'S MILL RD, TR OAK HOLLOW ROAD, 1.0 MILE ON LEFT

SUBDIVISION OAK HOLLOW BLOCK / SECTION ____ LOT 1 LOT AREA 2.142 ACRES SITE CLASS PS DESIGN FLOW 360 L.T.A.R. 0.25 SQD/FT²

Septic Tank: 1000 Gallons; STB 1012 Date 10-21-99
Pump Tank: ____ Gallons; PT ____ Date ____
Pump Make: ____ Model ____ Serial No. ____
Nitrification Field: No Fields 1 Square Feet EQ. TO 1440 Linear Feet 360+
No Lines FIVE Trench Width 36" Max Trench Bottom Depth 30" ~~Gravel~~ Depth SAND 6"

☐ New System ☐ Repair System Type: I, II, III, IV, V, VI
System Description: 25% REDUCTION - GRAVITY
Repair System Description: LOW PRESSURE PIPE
Maintenance Agreement Required: ☐ Yes ☒ No

☐ House/Mod. Home No. Bedrooms 3
☒ Mobile Home No. Bathrooms 2
☐ Business No. Employees ____
☐ Other ____


☐ Slab ☐ Crawl Space ☐ Basement w/plumbing ☐ Basement wo/plumbing

Water Supply: ☒ Individual ☐ Public ☐ Community
WELL


Comments/Conditions: ① KEEP SYSTEM MINIMUM 100 FEET FROM WELL ② INSTALL 25% REDUCTION SYSTEM USING 60 CHAMBERS OR 36 HDS SECTIONS ③ INSTALL SUBSURFACE INTERCEPT DRAINAGE DITCH AT LOCATION SHOWN BEGINNING 42" DEEP

Comments/Conditions: SEPTIC TANK W/ RISERS & MARKER INSTALLED USING "Pay LOK" FILTER

INITIAL SITE SKETCH

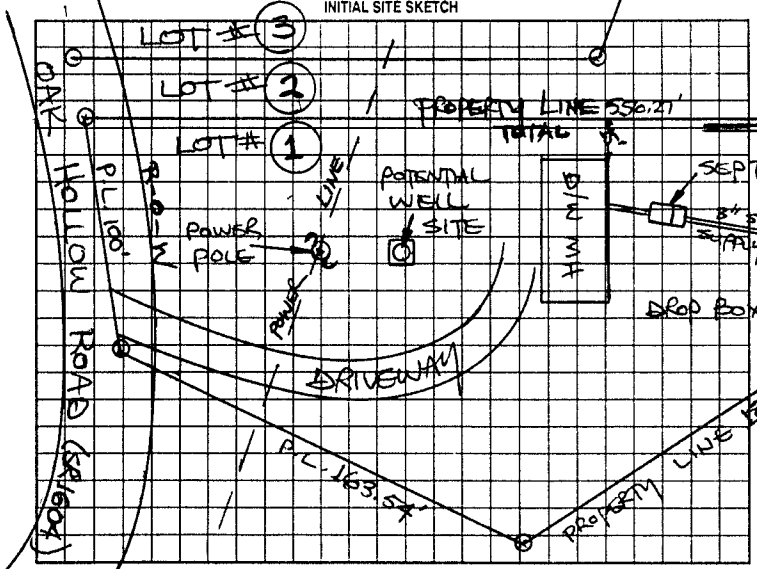

AS BUILT SKETCH

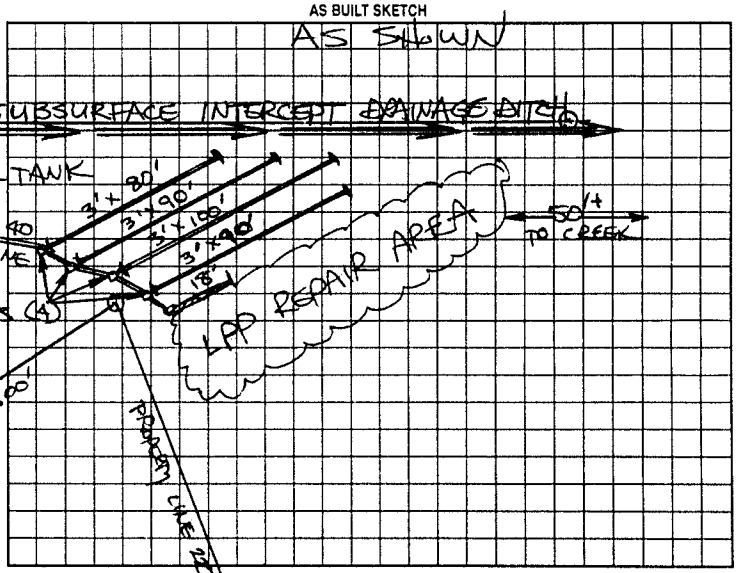

Permit can be suspended or revoked if any false information is supplied toward securing the permit/any unauthorized changes are made to the site/any unauthorized changes are made in the installation of the system. Improvement Permit with plat valid without expiration. Improvement Permit with site plan valid for sixty months. Authorization to Construct is valid for a period equal to that of Improvement Permit – not to exceed sixty months.

Signed: [signature] date 11-30-99 Installed by: A-1 BACKHOE

Improvement Permit by: STEVE HEDRICK date 11-16-99 Operation Permit by: STEVE HEDRICK date 12-30-99

Authorization to Construct by: STEVE HEDRICK date 11-16-99 Existing System Inspection by: ____ date ____

HEALTH DEPT. COPY: WHITE OWNER COPY (FINAL): YELLOW OWNER COPY (INITIAL): PINK