IREDELL COUNTY HEALTH DEPARTMENT

STATESVILLE 704-878-5305 MOORESVILLE 704-664-5281

IMPROVEMENT PERMIT / CERTIFICATE OF COMPLETION / OPERATION PERMIT / EXISTING SYSTEM INSPECTION

PROPERTY DESCRIPTION NO. 066766 DATE 6-24-97 TAX MAP NO. 4803776726 Watershed: ☐ Yes ☒ No

OWNER OR CONTRACTOR SUSAN E. COYNER PHONE: Business Home 539-5049

ADDRESS 164 ZION LIBERTY ROAD UNION GROVE NC 28689

LOCATION NC 115 N, TL UNNEYS MILL, TR OAK HOLLOW, ON LEFT JUST BEYOND HILLSDALE ROAD 0.25 MI

SUBDIVISION BLOCK / SECTION LOT LOT AREA 20 ACRES SITE CLASS. PS DESIGN FLOW 360 L.T.A.R. 0.33 GPD/FT²

Septic Tank: 1000 Gallons; STB 760 Date 9-4-97

Pump Tank: Gallons; PT Date

Pump Make: Model Serial No.

Nitrification Field: No Fields 1 Square Feet 1080 Linear Feet 360

No Lines THREE Trench Width 36" Max Trench Bottom Depth 30 Gravel Depth 12"

☒ New System ☐ Repair System Type: I, ☒ II, III, IV, V, VI

System Description: CONVENTIONAL GRAVITY

Repair System Description: CONV. GRAVITY

Maintenance Agreement Required: ☐ Yes ☒ No

☒ House/Mod. Home No. Bedrooms 3

☐ Mobile Home No. Bathrooms 2

☐ Business No. Employees


☐ Other

☐ Slab ☒ Crawl Space ☐ Basement w/plumbing ☐ Basement wo/plumbing

Water Supply: ☐ Individual ☐ Community ☐ Public

Comments: TEMPORARY MH TO BE REMOVED UPON OCCUPANCY OF HOUSE.

INITIAL SITE SKETCH SCALE: 1"=40'

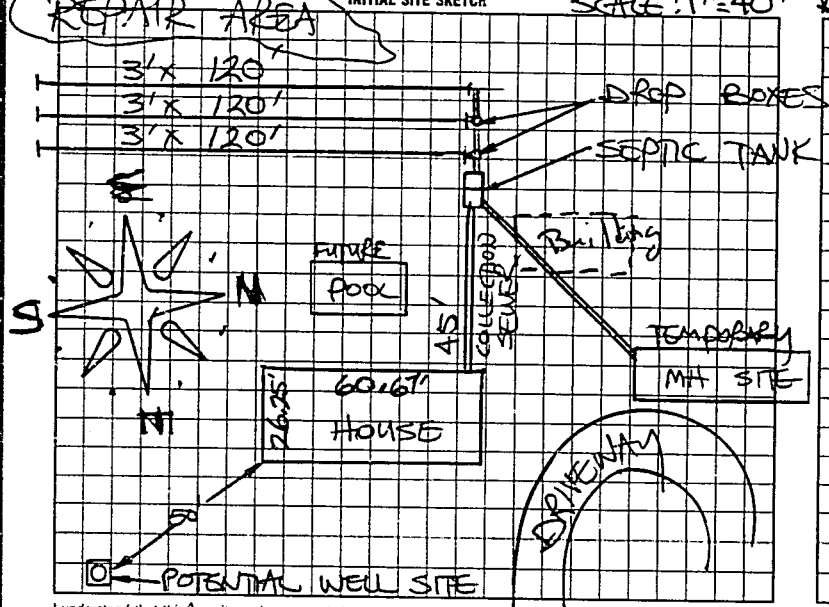


Comments:

* Note Separate Building set instead of M/H - Build other House Building must be disconnected

* also location of Building is closer than shown - spoke with property owner on these issues

AS BUILT SKETCH

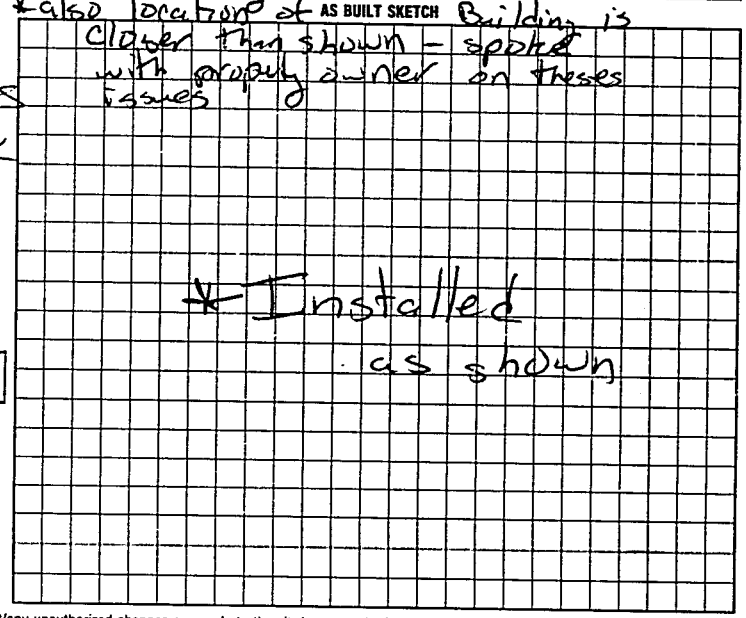

I understand that this permit can be suspended or revoked if any false information is supplied toward securing the permit/any unauthorized changes are made to the site/any unauthorized changes are made in the installation of the system. Improvement Permit is valid for 60 months from date of issuance. AUTHORIZATION TO CONSTRUCT IS VALID FOR 60 MONTHS FROM DATE OF ISSUANCE.

Signed: [signature]

Improvement Permit by: STEVE HEDRICK date 6-24-97

AUTH. TO CNST. ~~Existing System Inspection~~ by: STEVE HEDRICK date 6-24-97

Installed by: Grimes Septic Tank

~~Certificate of Completion by:~~ date

Operation Permit by: [signature] date 10-29-97

HEALTH DEPT. COPY: WHITE INSPECTION COPY (FINAL): GREEN OWNER COPY (FINAL): YELLOW INSPECTION COPY (INITIAL): PINK OWNER COPY (INITIAL): GOLD

0002 11