IREDELL COUNTY HEALTH DEPARTMENT

STATESVILLE 704-878-5305 MOORESVILLE 704-664-5281

IMPROVEMENT PERMIT / AUTHORIZATION TO CONSTRUCT / OPERATION PERMIT / EXISTING SYSTEM INSPECTION

PERMIT# 083322 PIN# 4803 78 8089 DATE 8-27-99

OWNER OR CONTRACTOR KENNETH JOHNSON PHONE: Business Home (704) 492-7567

ADDRESS 805 CALLAHAN ROAD MOCKSVILLE, NC 27028

LOCATION NC 115 N TL LINNEY'S MILL ROAD, TR OAK HOLLOW ROAD, ~0.8 MILE ON LEFT

SUBDIVISION OAK HOLLOW BLOCK / SECTION LOT 5 LOT AREA 1.18 ACRES SITE CLASS PS DESIGN FLOW 360 L.T.A.R. 0.30 GPD/FT2

Septic Tank: 1000 Gallons; STB 1012 Date 12-15-99

Pump Tank: Gallons; PT Date

Pump Make: Model Serial No.

Nitrification Field: No Fields 1 Square Feet 1200 Linear Feet 400

No Lines FOUR Trench Width 36" Max Trench Bottom Depth 36" Gravel Depth 12"

☑ New System ☐ Repair System Type: I (II) III, IV, V, VI

System Description: CONVENTIONAL GRAVITY

Repair System Description: CONV. GRAVITY

Maintenance Agreement Required: ☐ Yes ☑ No

☐ Slab ☑ Crawl Space ☐ Basement w/plumbing ☐ Basement wo/plumbing

☐ House/Mod. Home No. Bedrooms 3

☑ Mobile Home No. Bathrooms 2

☐ Business No. Employees

☐ Other


Water Supply: ☑ Individual ☐ Public ☐ Community WELL

Comments/Conditions: KEEP SYSTEM MINIMUM 100 FEET FROM WELL

Comments/Conditions SEPTIC TANK W/ RISERS INSTALLED USING "POLY LOK" FILTER

SCALE: 1" = 40'

INITIAL SITE SKETCH

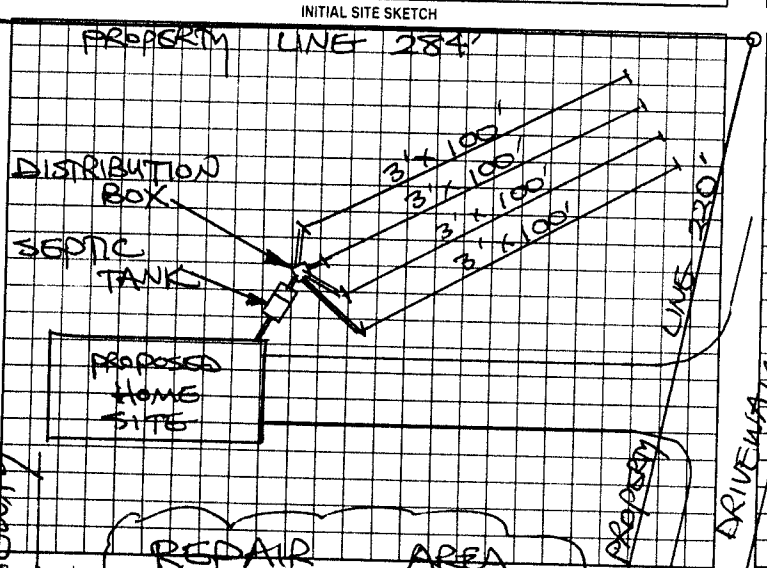

AS BUILT SKETCH

SYSTEM INSTALLED ACCORDING TO INITAL SITE SKETCH

Permit can be suspended or revoked if any false information is supplied toward securing the permit/any unauthorized changes are made to the site/any unauthorized changes are made in the installation of the system. Improvement Permit with plat valid without expiration. Improvement Permit with site plan valid for sixty months. Authorization to Construct is valid for a period equal to that of Improvement Permit - not to exceed sixty months.

Signed: X 8-Kenneth Johnson date 8-27-99

Improvement Permit by: STEVE HEDRICK date 8-27-99

Authorization to Construct by: STEVE HEDRICK date 8-27-99

Installed by: STEVE JORDAN

Operation Permit by: STEVE HEDRICK date 4-19-00

Existing System Inspection by: date

HEALTH DEPT COPY: WHITE OWNER COPY (FINAL) YELLOW OWNER COPY (INITIAL) PINK