IREDELL COUNTY HEALTH DEPARTMENT

STATESVILLE 704-878-5305 (CV) MOORESVILLE 704-664-5281

IMPROVEMENT PERMIT / AUTHORIZATION TO CONSTRUCT / OPERATION PERMIT / EXISTING SYSTEM INSPECTION

PERMIT# 118093 PIN# 4803-83-1749 DATE 2-2-04

OWNER OR CONTRACTOR PAM CHASE PHONE: Business Home 704-393-7152

ADDRESS 8027 TROTTER ROAD, CHARLOTTE NC 28216

LOCATION NC 115 NORTH TL LINNEY'S MILL ROAD, 2.7 MILES ON RIGHT (2ND ON RIGHT PAST HILLSDALE RD)

SUBDIVISION BRUSHY MTN ACRES BLOCK / SECTION LOT 7 LOT AREA 7.2 ACRES SITE CLASS. PS DESIGN FLOW 480 L.T.A.R. 0.30 GPD/FT²

Septic Tank: 1000 Gallons; STB 1012 Date 7-20-04
Pump Tank: Gallons; PT Date
Pump Make: Model Serial No.
Nitrification Field: No Fields 1 Square Feet 1600 Linear Feet 540
No Lines SIX Trench Width 36" Max Trench Bottom Depth 36" Gravel Depth 12"

☑ New System ☐ Repair System Type: I, II, III, IV, V, VI
System Description: CONVENTIONAL, GRAVITY
Repair System Description: CONVENTIONAL, GRAVITY
Maintenance Agreement Required: ☐ Yes ☑ No

☑ House/Mod. Home No. Bedrooms 4
☐ Mobile Home No. Bathrooms 3
☐ Business No. Employees
☐ Other


☐ Slab ☐ Crawl Space ☑ Basement w/plumbing ☐ Basement wo/plumbing

Water Supply: ☑ Individual ☐ Public ☐ Community
WELL


Comments:/Conditions: ① KEEP SYSTEM MINIMUM 100 FEET FROM WELL ② INSTALL LINES ON CONTOUR AS FLAGGED. ③ NO VEHICULAR TRAFFIC ALLOWED OVER SYSTEM

Comments:/Conditions: SEPTIC TANK WITH MARKER INSTALLED USING "TUFTITE" FILTER

INITIAL SITE SKETCH

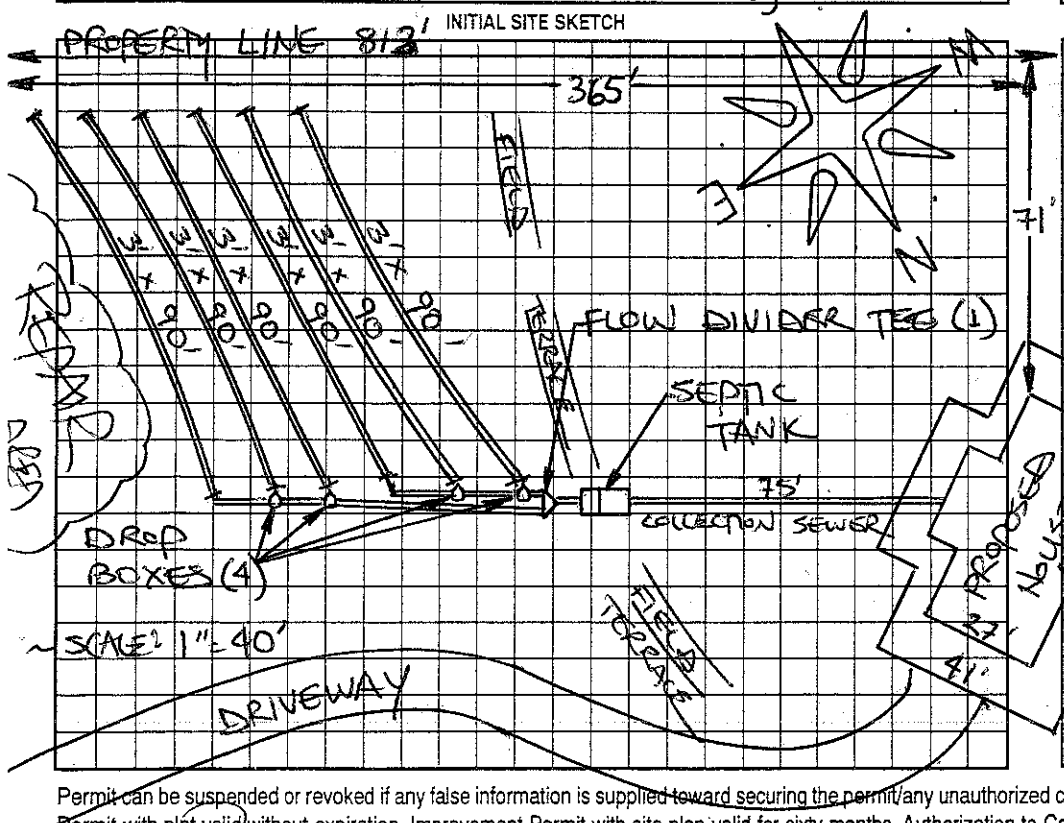

AS BUILT SKETCH

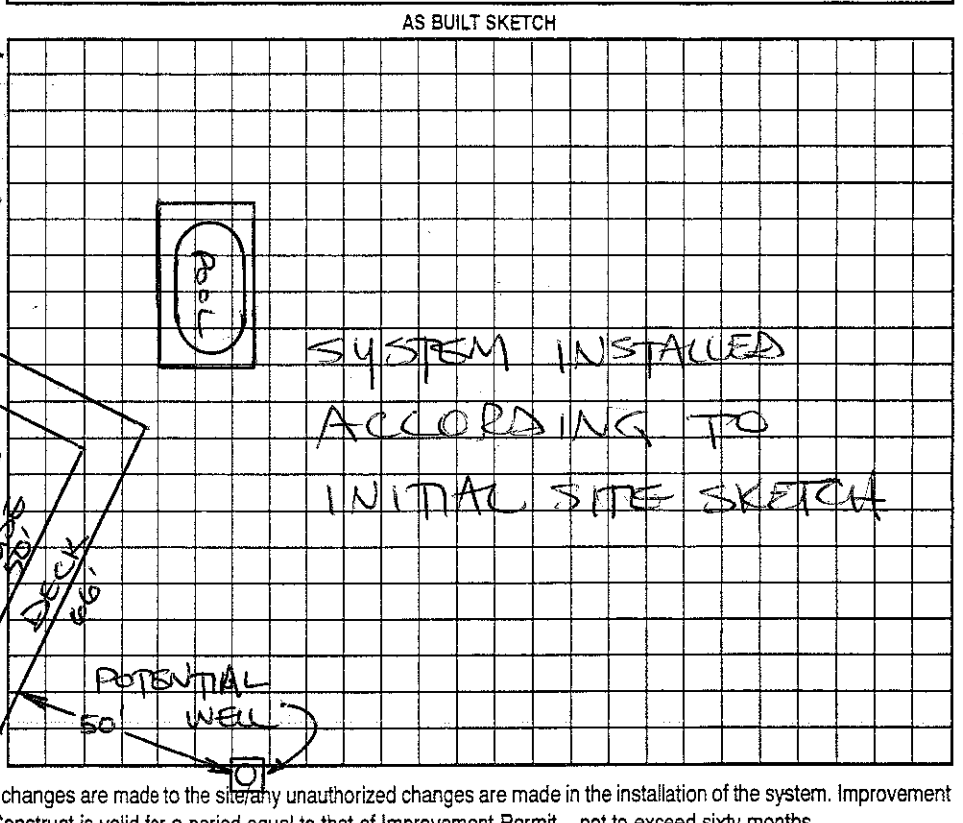

Permit can be suspended or revoked if any false information is supplied toward securing the permit/any unauthorized changes are made to the site/any unauthorized changes are made in the installation of the system. Improvement Permit with plat valid without expiration. Improvement Permit with site plan valid for sixty months. Authorization to Construct is valid for a period equal to that of Improvement Permit – not to exceed sixty months.

Signed: Pam Chase date 2-2-04 Installed by: TOMMY FRYE

Improvement Permit by: STEVE HEDRICK date 2-2-04 Operation Permit by: STEVE HEDRICK date 2-11-05

Authorization to Construct by: STEVE HEDRICK date 2-2-04 Existing System Inspection by: date

HEALTH DEPT. COPY: WHITE OWNER COPY (FINAL): YELLOW OWNER COPY (INITIAL): PINK