IREDELL COUNTY HEALTH DEPARTMENT

STATESVILLE 704-878-5305 MOORESVILLE 704-664-5281

IMPROVEMENT PERMIT / AUTHORIZATION TO CONSTRUCT / OPERATION PERMIT / EXISTING SYSTEM INSPECTION

PERMIT# 081997 PIN# 4803 84 2873 DATE 6-30-99

OWNER OR CONTRACTOR DON KRUEL PHONE: Business Home 664-1112

ADDRESS 120 BIRCH COURT MOORESVILLE, NC 28117

LOCATION NC 115 NORTH, TL LINNEY'S MILL RD TR HILLSDALE ROAD, 0.1 MILE ON LEFT

SUBDIVISION BLOCK / SECTION LOT 5 LOT AREA 4.54 ACRES SITE CLASS PS DESIGN FLOW 360 L.T.A.R. 0.50 GPD/FT²

Septic Tank: 1000 Gallons, STB 1000 Date 10-15-99

Pump Tank: Gallons; PT Date

Pump Make: Model Serial No

Nitrification Field: No Fields 1 Square Feet 720 Linear Feet 240

No Lines THREE Trench Width 36" Max Trench Bottom Depth 36" Gravel Depth 12"

✓ New System Repair System Type: I II III IV V VI

System Description: CONVENTIONAL GRAVITY

Repair System Description: CONVENTIONAL GRAVITY

Maintenance Agreement Required: Yes ✓ No

✓ House/Mod. Home No. Bedrooms 3

Mobile Home No. Bathrooms 2

Business No. Employees

Other

Slab Crawl Space ✓ Basement w/plumbing Basement wo/plumbing


Water Supply: ~~Individual~~ Public ☐ Community WELL

Comments/Conditions: KEEP SYSTEM MINIMUM 100 FEET FROM WELL

Comments/Conditions: SEPTIC TANK WITH RISERS AND MARKER INSTALLED USING "ZABEL" FILTER

SCALE: 1" = 40'

INITIAL SITE SKETCH

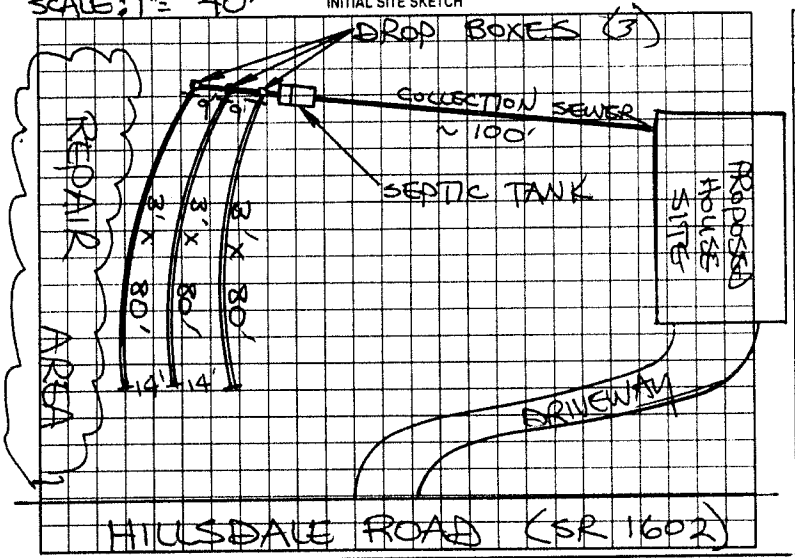

AS BUILT SKETCH

SYSTEM INSTALLED ACCORDING TO INITIAL SITE SKETCH

Permit can be suspended or revoked if any false information is supplied toward securing the permit; any unauthorized changes are made to the site; any unauthorized changes are made in the installation of the system. Improvement Permit with plat valid without expiration. Improvement Permit with site plan valid for sixty months. Authorization to Construct is valid for a period equal to that of Improvement Permit – not to exceed sixty months.

Signed: Donald V. Kruel date 6/30/99

Improvement Permit by: STEVE HEDRICK date 6-30-99

Authorization to Construct by: STEVE HEDRICK date 6-30-99

Installed by: BILL ADAMS

Operation Permit by: STEVE HEDRICK date 12-2-99

Existing System Inspection by: date

HEALTH DEPT COPY WHITE OWNER COPY (FINAL) YELLOW OWNER COPY (INITIAL) PINK