IREDELL COUNTY HEALTH DEPARTMENT

STATESVILLE 704-878-5305 (a) MOORESVILLE 704-664-5281

IMPROVEMENT PERMIT / AUTHORIZATION TO CONSTRUCT / OPERATION PERMIT / EXISTING SYSTEM INSPECTION

PERMIT # 16548 + 131176 PIN # 4803-86-8723 DATE 4-5-11

OWNER or APPLICANT (BARN) Johnny Shuler + Lisa Honeycutt PHONE: Business 828-612-6490 Home:

OWNER or APPLICANT ADDRESS 195 Oak Hollow Rd - Union Grove

LOCATION / DIRECTIONS I-15N; (L) Linney's Mill Rd on left before Hillsdale (R) on Oak Hollow

SUBDIVISION n/a BLOCK / SECTION n/a LOT # n/a LOT AREA 11.9 DESIGN FLOW 360 L.T.A.R. .25

Septic Tank 1000 Gallons: STB 150 Date 6-13-11

Pump Tank Gallons: P T Date

Pump Make Model Serial #

Nitrification Field No Fields 1 No Lines 3 Linear Feet 360

Trench Width 36" Max. Trench Bottom Depth 36" Gravel Depth n/a

☒ New System ☐ Repair ☐ Expansion System Type I II (III) IV V VI

System Description: 25% Reduction Gravity

Repair System Description: 25% Reduction Gravity

Maintenance Agreement Required ☐ YES ☒ NO

☒ GRAVITY ☐ PRESSURE

☒ Residence No. Bedrooms 3

☐ Business No. Persons

☐ Other No. Employees

☐ Slab ☒ Crawl Space

☐ Basement w/plumbing ☐ Basement w/o plumbing


Water Supply: ☒ Private ☐ Public ☐ Community

Comments / Conditions


Initially, system will be installed for barn. However, system is to be sized to handle both barn and future house.

Comments / Conditions

INITIAL SITE SKETCH

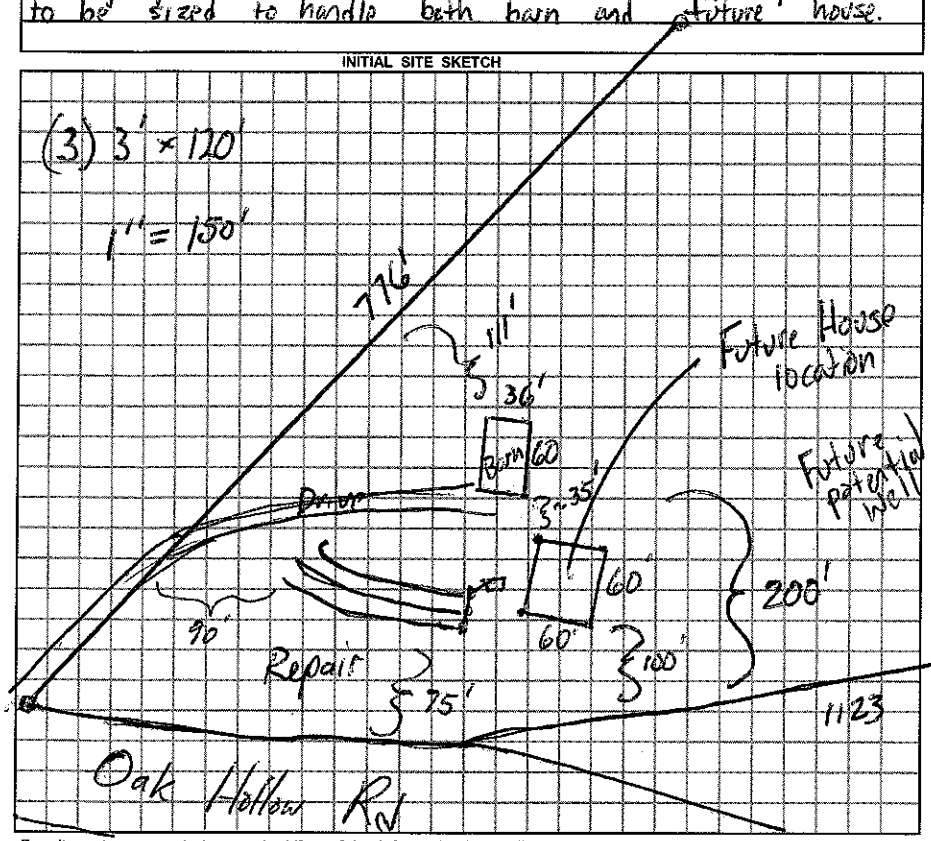

AS BUILT SKETCH

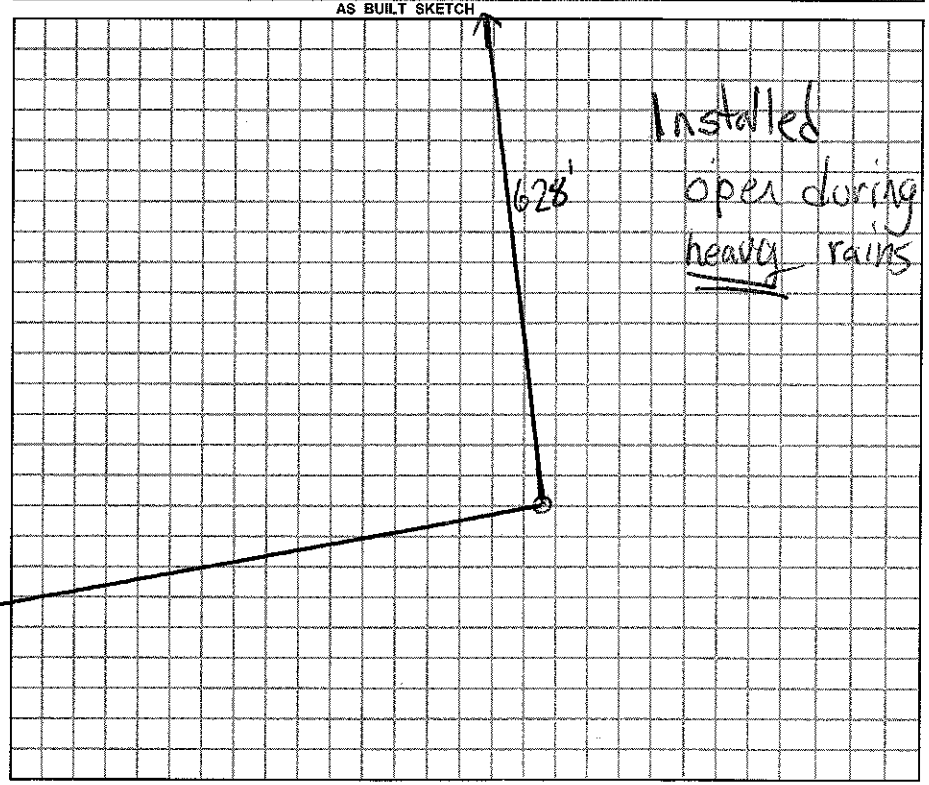

Permit can be suspended or revoked if any false information is supplied toward securing the permit / any unauthorized changes are made to the site / any unauthorized changes are made in the installation of the system.

☐ *IMPROVEMENT PERMIT w / plat valid without expiration.* ☒ *IMPROVEMENT PERMIT w / site plan valid for 60 mos.* ☒ *AUTHORIZATION TO CONSTRUCT valid for period equal to IMPROVEMENT PERMIT-not to exceed 60 mo.*

Owner / Applicant Signature: Johnny Shuler Date 4-7-11

Improvement Permit by: Date 4-5-11

Authorization to Construct by: Date 4-5-11

YOU SHOULD CONTACT A LOCATOR SERVICE PRIOR TO ANY EXCAVATION.

Installed by: Johnny Shuler

Operation Permit by: Date: 9-8-11

Existing System Inspected by: Date:

WHITE COPY Environmental Health YELLOW COPY (Final) Owner / Applicant PINK COPY (Initial) Owner / Applicant