1:15

# IREDELL COUNTY HEALTH DEPARTMENT

Statesville Office (704) 878-5305 Mooresville Office (704) 660-3625 PERMIT # 177248

## IMPROVEMENT PERMIT / AUTHORIZATION TO CONSTRUCT / OPERATION PERMIT / EXISTING SYSTEM

PIN # 4803871857

APPLICANT: Christopher and Audrey D Sullivan APPLICANT ADDRESS: 275 Oak Hollow Rd Union Grove

SITE ADDRESS: 275 Oak Hollow Rd. PHONE: 828-635-7769 ALT. PHONE: 828-404-6013

SITE DIRECTIONS: 115N to (L) on Linney's Mill (R) on Oak Hollow, property on (L) @ 275


SUBDIVISION: n/a SECTION: n/a LOT # n/a LOT AREA: .685 DESIGN FLOW: 240 L.T.A.R.: .3

| | | | | | | | | | |
|---|---|---|---|---|---|---|---|---|---|
| Septic Tank | 1000 (gal) | STB | 160 | Date | 11-5-12 | [X] New System [ ] Repair [ ] Expansion | System Type: I II (III) IV V VI | [X] Residence | No. Bedrooms 2 |
| Pump Tank | (gal) | PT | | Date | | System Description: | 25% Expand Reduction Gravity | [ ] Business | No. Persons |
| Pump Make | Model | | | Serial # | | Repair System Description: | 25% Reduction Gravity | [ ] Other | No. Employees |
| # Nitrification Fields | 1 # Lines | | | Linear Ft: | 200 | Maintenance Agreement Required: | [ ] YES [X] NO | [ ] Slab | [X] Crawl Space |
| Trench Width | 36" Max. Trench Bottom Depth | | 36" | Gravel Depth | n/a | [X] GRAVITY | [ ] PRESSURE | [ ] Basement w/plumbing | [ ] Basement w/o plumbing |


Water Supply: [X] Private [ ] Public [ ] Community

Comments / Conditions: Grade area next to house and "Old Driveway" to smooth topography.

INITIAL SITE SKETCH

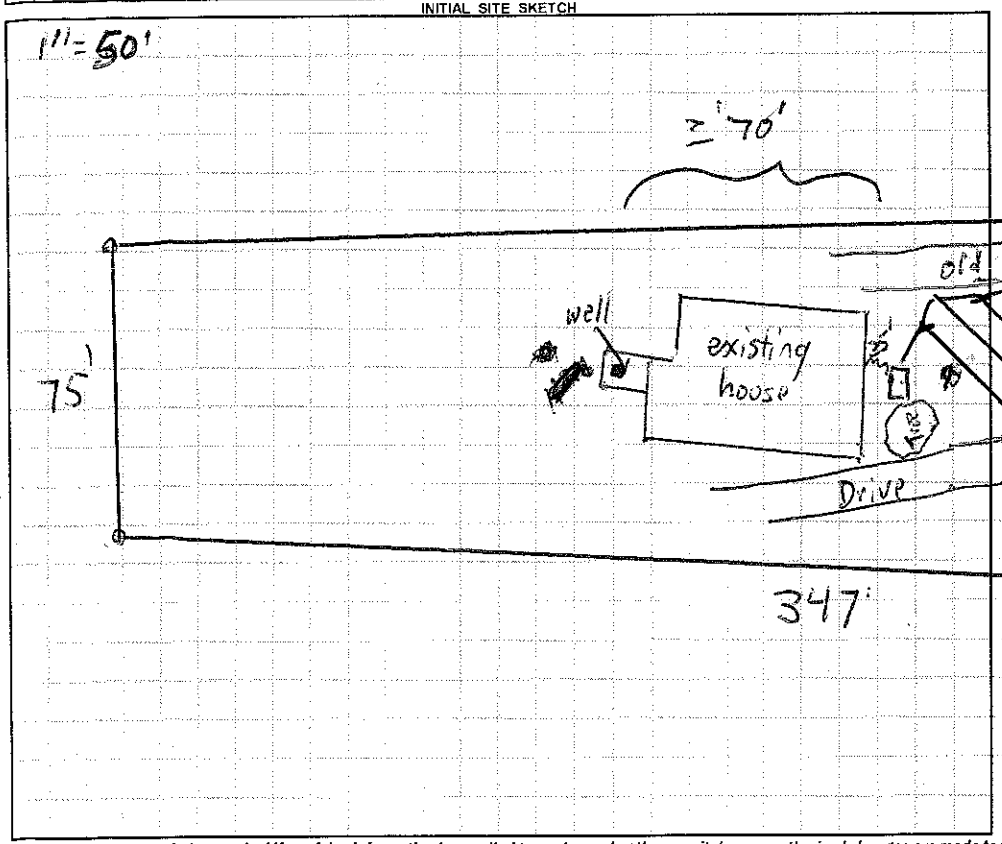


AS BUILT SKETCH

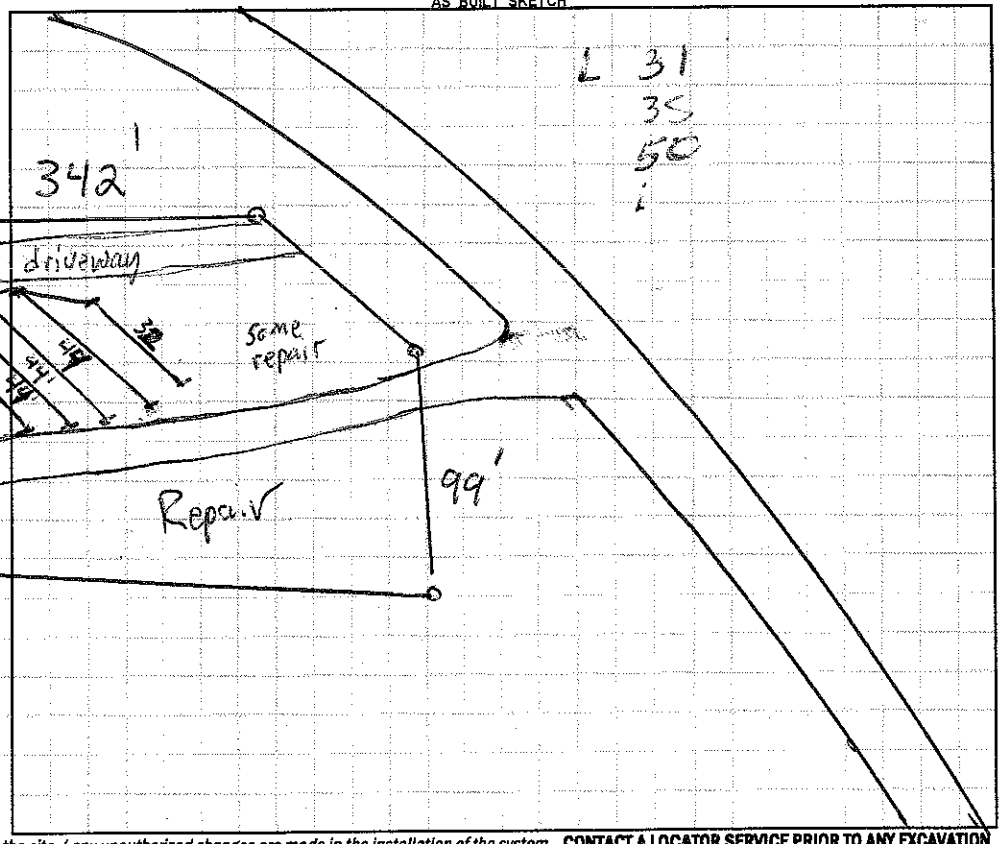


*Permit can be suspended or revoked if any false information is supplied toward securing the permit / any unauthorized changes are made to the site / any unauthorized changes are made in the installation of the system.* **CONTACT A LOCATOR SERVICE PRIOR TO ANY EXCAVATION**

[ ] **IMPROVEMENT PERMIT** *with plat valid without expiration.* [X] **IMPROVEMENT PERMIT** *with site plan valid for 60 mos.* [X] **AUTHORIZATION TO CONSTRUCT** *valid for period equal to IMPROVEMENT PERMIT--not to exceed 60 mo.*

Owner / Applicant Signature: Audrey Sullivan Date: Installed by: Kevin Bowles

IMPROVEMENT PERMIT by: Date: 3-15-13 OPERATION PERMIT by: Date: 3-26-13

AUTHORIZATION TO CONSTRUCT by: Date: 3-18-13 Existing System Inspected by: Date:

Health Dept. Copy - WHITE Applicant (Final Approval) - YELLOW Applicant (Conditional Approval) - PINK