IREDELL COUNTY HEALTH DEPARTMENT

STATESVILLE 704-878-5306 MOORESVILLE 704-664-5281

IMPROVEMENT PERMIT / AUTHORIZATION TO CONSTRUCT / OPERATION PERMIT / EXISTING SYSTEM INSPECTION

PERMIT # 158664 PIN # 4803-94-1688 DATE 11 December 09

OWNER or APPLICANT William Orford PHONE: Business (704) 592-2541 Home:

OWNER or APPLICANT ADDRESS 770 Linneys Mill Rd. Union Grove

LOCATION / DIRECTIONS 115 N Th Linneys Mill Rd. TR Hillsdale - Prop. on Rt.

SUBDIVISION BLOCK / SECTION LOT # LOT AREA 46.46 DESIGN FLOW 360 gpd L.T.A.R. 0.3 gal/sq ft

Septic Tank 1000 Gallons: STB 794 Date 3-1-10

Pump Tank Gallons: P T Date

Pump Make Model Serial #

Nitrification Field No Fields 1 No Lines 4 Linear Feet 400

Trench Width 36" Max. Trench Bottom Depth 30" Gravel Depth 12"

☑ New System ☐ Repair ☐ Expansion System Type I (II) III IV V VI

System Description: ~~Reduction~~ Conventional

Repair System Description: ~~Sys~~ Conventional

Maintenance Agreement Required ☐ YES ☑ NO

☑ GRAVITY ☐ PRESSURE

☑ Residence No. Bedrooms 3

☐ Business No. Persons

☐ Other No. Employees

☐ Slab ☐ Crawl Space


☑ Basement w/plumbing ☐ Basement w/o plumbing

Water Supply: ☑ Private ☐ Public ☐ Community


Comments / Conditions # Manhole installed as an Accepted system @ 3 lines x 100' in length. & follow conf. / Remove power terminal

Comments / Conditions

INITIAL SITE SKETCH

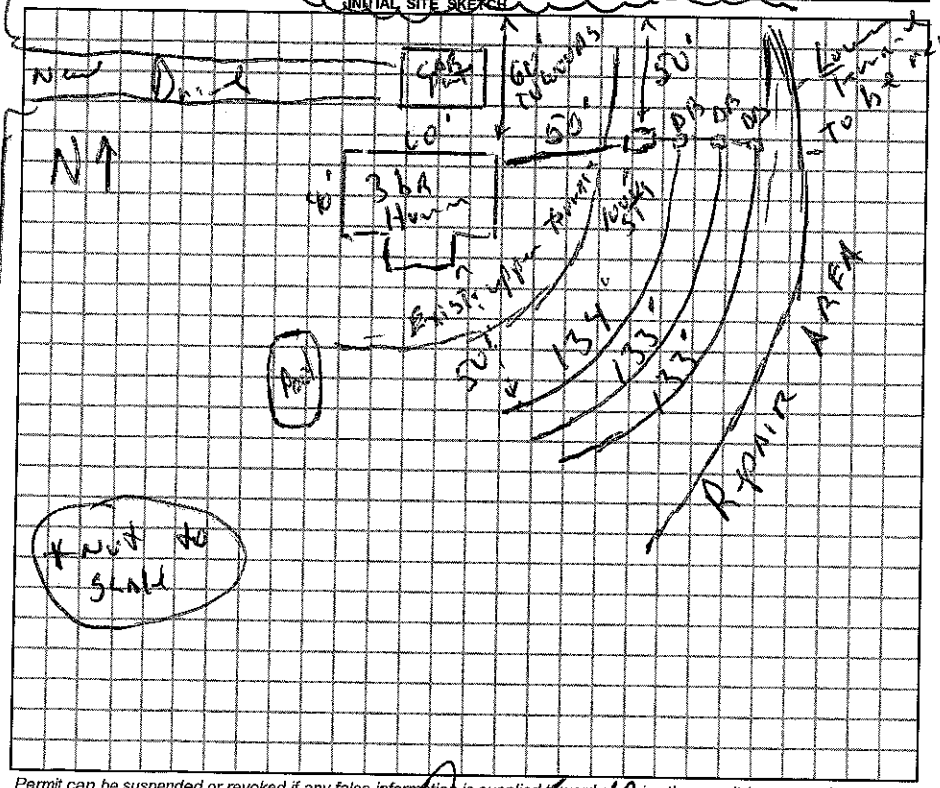

AS BUILT SKETCH

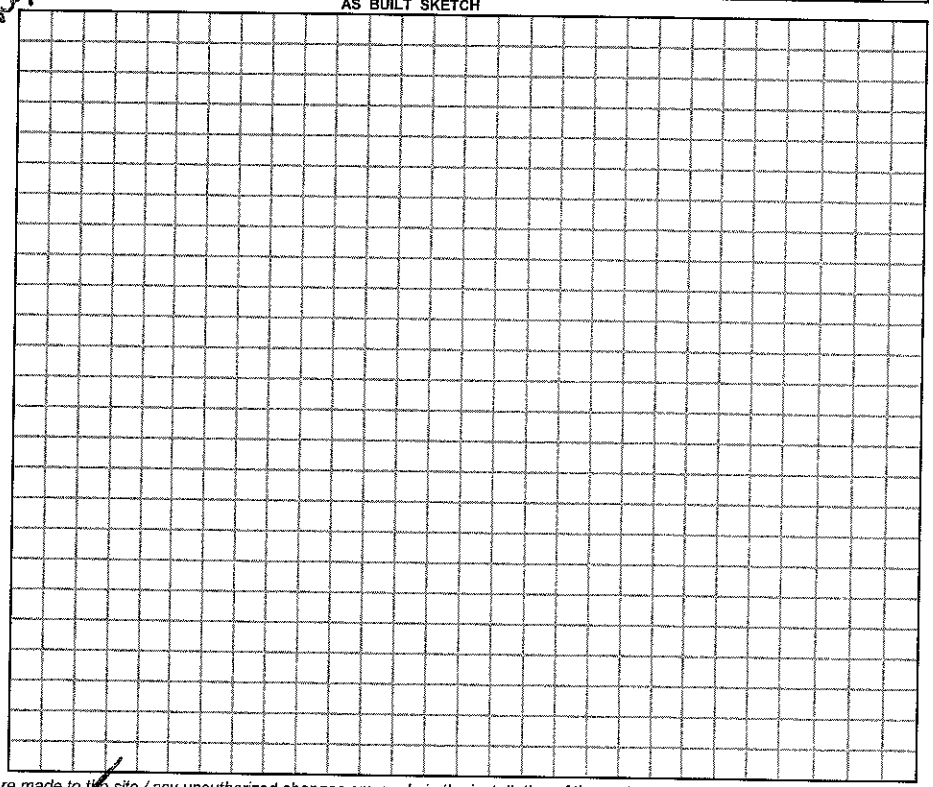

Permit can be suspended or revoked if any false information is supplied toward securing the permit / any unauthorized changes are made to the site / any unauthorized changes are made in the installation of the system.

☐ IMPROVEMENT PERMIT w / plat valid without expiration. ☑ IMPROVEMENT PERMIT w / site plan valid for 60 mos. ☑ AUTHORIZATION TO CONSTRUCT valid for period equal to IMPROVEMENT PERMIT-not to exceed 60 mo.

Owner / Applicant Signature: William Orford Date 12/14/09

Improvement Permit by: R.S. Date 11 Dec 09

Authorization to Construct by: R.S. Date 11 Dec 09

YOU SHOULD CONTACT A LOCATOR SERVICE PRIOR TO ANY EXCAVATION.

Installed by: Madison Grading

Operation Permit by: James Date: 4-27-10

Existing System Inspected by: Date:

WHITE COPY Environmental Health YELLOW COPY (Final) Owner / Applicant PINK COPY (Initial) Owner / Applicant