IREDELL COUNTY HEALTH DEPARTMENT

STATESVILLE 704-878-5305   MOORESVILLE 704-664-5281

IMPROVEMENT PERMIT / AUTHORIZATION TO CONSTRUCT / OPERATION PERMIT / EXISTING SYSTEM INSPECTION

PERMIT # 158664   PIN # 4803-94-1688   DATE 11 December 09

OWNER or APPLICANT William Orford

OWNER or APPLICANT ADDRESS 770 Linneys Mill Rd. Union Grove   PHONE: Business (704) 592-2541   Home:

LOCATION / DIRECTIONS 115 N Th Linneys Mill Rd. TR Hillsdale - Prop. on Rt.

SUBDIVISION   BLOCK / SECTION   LOT #   LOT AREA 4646   DESIGN FLOW 360g/d   L.T.A.R. 0.3g/ft²

Septic Tank 1000 Gallons: STB   Date

Pump Tank   Gallons: P T   Date

Pump Make   Model   Serial #

Nitrification Field No Fields 1   No Lines 4   Linear Feet 400

Trench Width 36"   Max. Trench Bottom Depth 36"   Gravel Depth 12"   ☒ GRAVITY ☐ PRESSURE

☒ New System ☐ Repair ☐ Expansion System   Type I (II) III IV V VI

System Description: ~~Reduction~~ Conventional

Repair System Description: ~~25%~~ Conventional

Maintenance Agreement Required ☐ YES ☒ NO


☒ Residence   No. Bedrooms 3
☐ Business   No. Persons
☐ Other   No. Employees
☐ Slab   ☐ Crawl Space
☒ Basement w/plumbing   ☐ Basement w/o plumbing

Water Supply ☒ Private ☐ Public ☐ Community

Comments / Conditions: * May be installed as an accepted system / @ 3 lines x 100' in length. * Follow contour / Remove lower terrace / woods

Comments / Conditions:

INITIAL SITE SKETCH

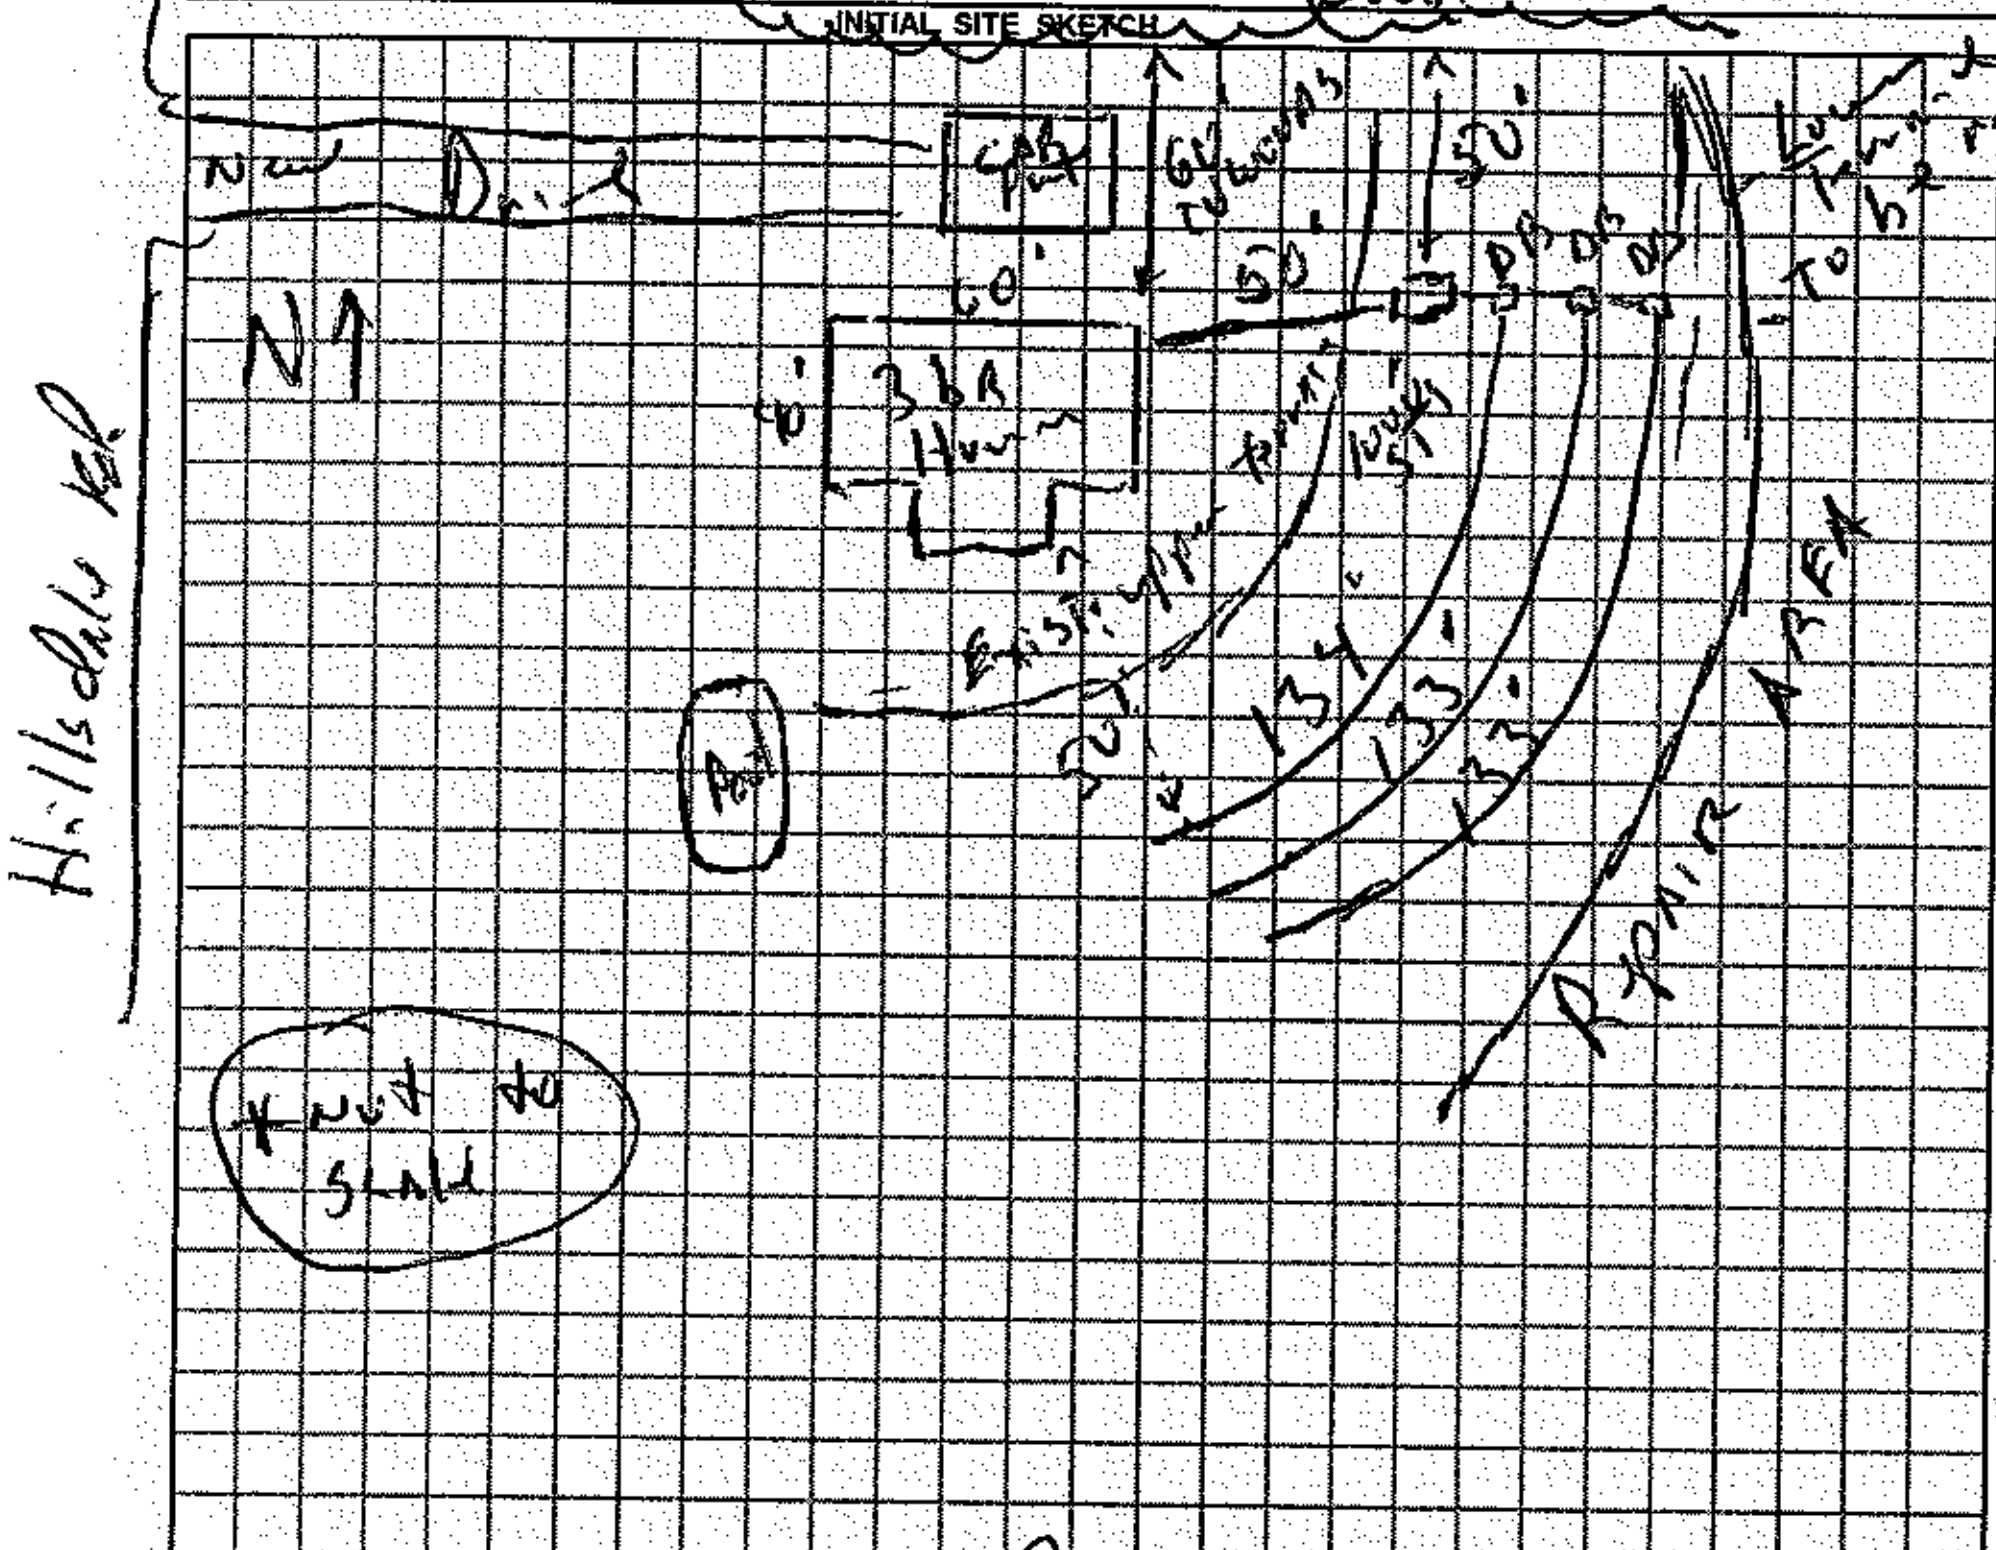

AS BUILT SKETCH

The proposed Inground pool addition does not appear to impact the ~~existing~~ proposed septic system.

**NOTE:

[signature] R.S.

Date: 1-29-2010

ICHD-Environmental Health Division

Permit can be suspended or revoked if any false information is supplied toward securing the permit / any unauthorized changes are made to the site / any unauthorized changes are made in the installation of the system.

☐ *IMPROVEMENT PERMIT w / plat valid without expiration.* ☒ *IMPROVEMENT PERMIT w / site plan valid for 60 mos.* ☒ *AUTHORIZATION TO CONSTRUCT valid for period equal to IMPROVEMENT PERMIT-not to exceed 60 mo.*

Owner / Applicant Signature: [signature] Date 12/14/09

Improvement Permit by: [signature] R.S. Date 11 Dec. 09

Authorzation to Construct by: [signature] R.S. Date 11 Dec. 09

YOU SHOULD CONTACT A LOCATOR SERVICE PRIOR TO ANY EXCAVATION.

Installed by:

Operation Permit by: Date:

Existing System Inspected by: Date:

WHITE COPY Environmental Health   YELLOW COPY (Final) Owner / Applicant   PINK COPY (Initial) Owner / Applicant