See attached permit 165576 for home closet addition 4/2011.

# IREDELL COUNTY HEALTH DEPARTMENT

STATESVILLE 704-878-5305 MOORESVILLE 704-664-5281

## IMPROVEMENT PERMIT / AUTHORIZATION TO CONSTRUCT / OPERATION PERMIT / EXISTING SYSTEM INSPECTION

PERMIT# 126074 PIN# 4810-09-6069 8019 DATE 2-28-05

OWNER OR CONTRACTOR DANNY M. LIPPARD CONSTRUCTION & REMODELING, LLC PHONE: Business (704) 871-1800 Home

ADDRESS PO BOX 629 STATESVILLE NC 28677

LOCATION HWY 115N TL MOUNTAINVIEW TL BROOK HAVEN TL SHOEMAKER FARM 0.4 MILE ON LEFT IN BIG CURVE

SUBDIVISION BLOCK / SECTION LOT LOT AREA 58.82 SITE CLASS. PS DESIGN FLOW 360/480 L.T.A.R. 0.25 gpd/ft²

Septic Tank: 1000 Gallons; STB 1017 Date 6-7-05
Pump Tank: Gallons; PT Date
Pump Make: Model Serial No.
Nitrification Field: No Fields 1 Square Feet 1440 Linear Feet 480
No Lines 4 Trench Width 36" Max Trench Bottom Depth 36" Gravel Depth 12"

☑ New System ☐ Repair System Type: I, II, III, IV, V, VI
System Description: 2 CONVENTIONAL GRAVITY
Repair System Description: SAME
Maintenance Agreement Required: ☐ Yes ☑ No

☑ House/Mod. Home No. Bedrooms 3
☐ Mobile Home No. Bathrooms 4
☐ Business No. Employees
☐ Other

☐ Slab ☑ Crawl Space ☐ Basement w/plumbing ☐ Basement wo/plumbing


Water Supply: ☑ Individual ☐ Public ☐ Community

Comments:/Conditions: ① INSTALL LINES ON CONTOUR
② MAINTAIN ALL SETBACKS


Comments:/Conditions: THIS PERMIT WAS REVISED ON 2-9-2006 TO 4 BR W/ 25% REDUCTION SYSTEM ② SEPTIC TANK WITH MARKER INSTALLED USING "TUFFTE" FILTER

INITIAL SITE SKETCH

* 1" = 100'

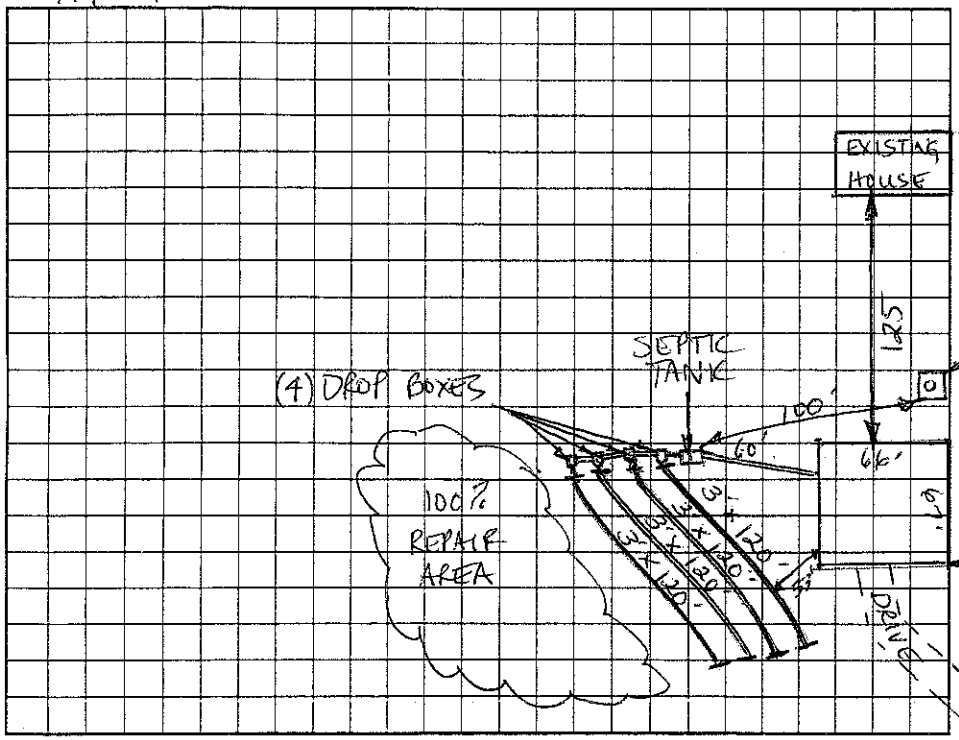


AS BUILT SKETCH

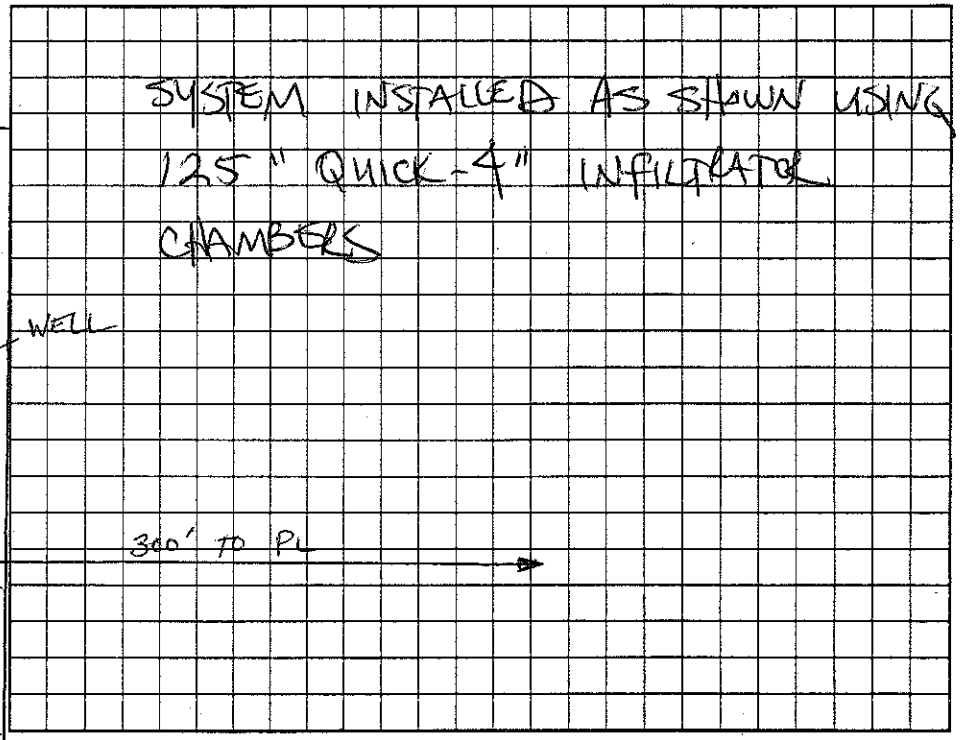


Permit can be suspended or revoked if any false information is supplied toward securing the permit/any unauthorized changes are made to the site/any unauthorized changes are made in the installation of the system. Improvement Permit with plat valid without expiration. Improvement Permit with site plan valid for sixty months. Authorization to Construct is valid for a period equal to that of Improvement Permit – not to exceed sixty months.

Signed: Danny M. Lippard date 3-4-05

Improvement Permit by: Christopher M. Shemwell PS, LSS date 2-28-05

Authorization to Construct by: Christopher M. Shemwell PS, LSS date 2-28-05

Installed by: DAVID YOUNTZ

Operation Permit by: STEVE HEDRICK date 2-9-06

Existing System Inspection by: date

HEALTH DEPT. COPY: WHITE OWNER COPY (FINAL): YELLOW OWNER COPY (INITIAL): PINK