IREDELL COUNTY HEALTH DEPARTMENT

STATESVILLE 704-878-5305 MOORESVILLE 704-664-5281

IMPROVEMENT PERMIT / AUTHORIZATION TO CONSTRUCT / OPERATION PERMIT / EXISTING SYSTEM INSPECTION

PERMIT# 126074 PIN# 4810-09-6069 8019 DATE 2-28-05

OWNER OR CONTRACTOR DANNY M. LIPPARD CONSTRUCTION & REMODELING, LLC PHONE: Business (704) 871-1800 Home

ADDRESS PO BOX 629 STATESVILLE NC 28677

LOCATION HWY 115N TL MOUNTAINVIEW TL BROOKHAVEN TL SHOEMAKER FARM 0.4 MILE ON LEFT IN BIG CURVE

SUBDIVISION BLOCK / SECTION LOT LOT AREA 58.82 SITE CLASS. PS DESIGN FLOW 360 480 L.T.A.R. 0.25 gpd/ft²

Septic Tank: 1000 Gallons; STB 1012 Date 6-7-05

Pump Tank: Gallons; PT Date

Pump Make: Model Serial No.

Nitrification Field: No Fields 1 Square Feet 1440 Linear Feet 480

No Lines 4 Trench Width 36" Max Trench Bottom Depth 36" Gravel Depth 12"

☑ New System ☐ Repair System Type: I, II, III, IV, V, VI

System Description: CONVENTIONAL GRAVITY

Repair System Description: SAME

Maintenance Agreement Required: ☐ Yes ☑ No

☑ House/Mod. Home No. Bedrooms 3 4

☐ Mobile Home No. Bathrooms 4

☐ Business No. Employees

☐ Other


☐ Slab ☑ Crawl Space ☐ Basement w/plumbing ☐ Basement wo/plumbing

Water Supply: ☑ Individual ☐ Public ☐ Community


Comments/Conditions: ① INSTALL LINES ON CONTOUR
② MAINTAIN ALL SETBACKS

Comments/Conditions: ① THIS PERMIT WAS REVISED ON 2-9-2006 TO 4 BR W/ 25% REDUCTION SYSTEM ② SEPTIC TANK WITH MARKER INSTALLED USING "TUFFTE" FILTER

INITIAL SITE SKETCH

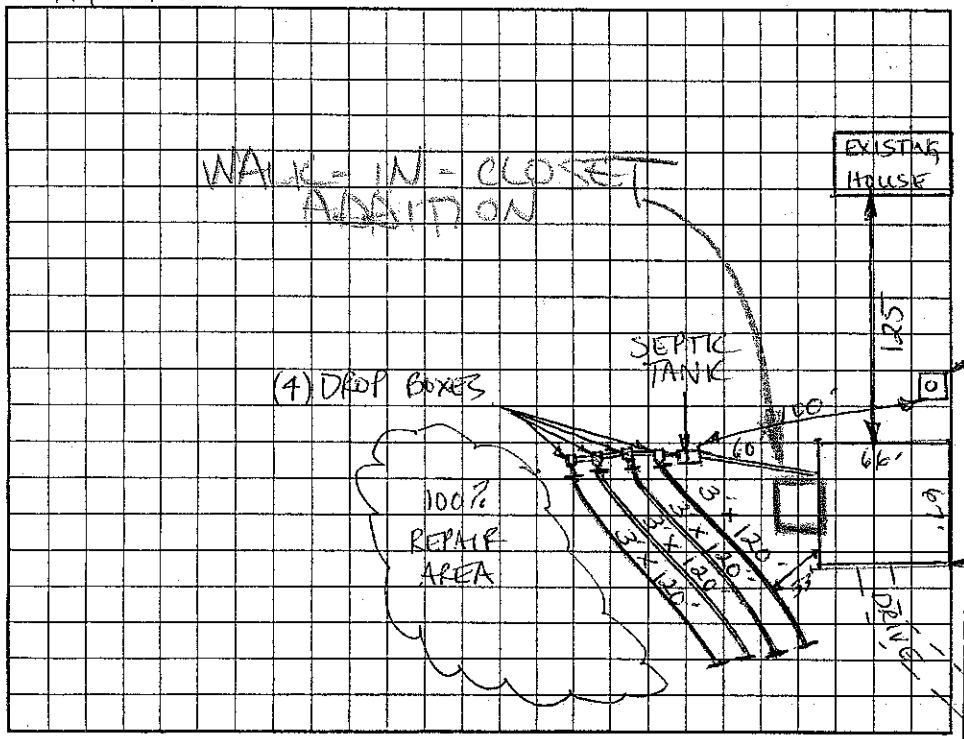

AS BUILT SKETCH

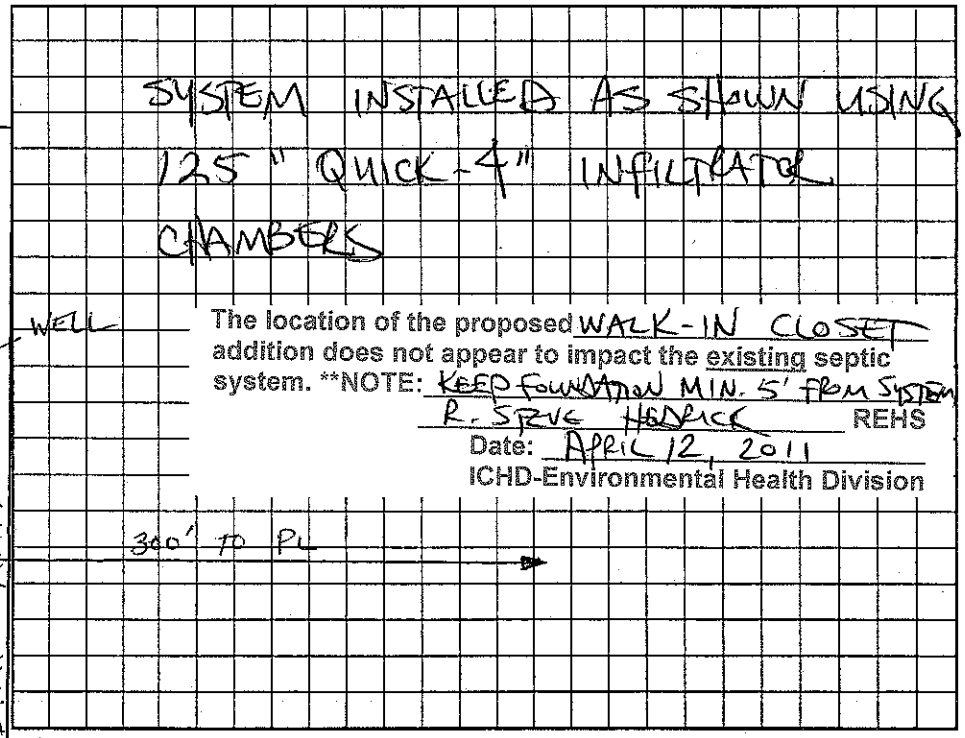

The location of the proposed WALK-IN CLOSET addition does not appear to impact the existing septic system. **NOTE: KEEP FOUNDATION MIN. 5' FROM SYSTEM
R. STEVE HEDRICK REHS
Date: APRIL 12, 2011
ICHD-Environmental Health Division

Permit can be suspended or revoked if any false information is supplied toward securing the permit/any unauthorized changes are made to the site/any unauthorized changes are made in the installation of the system. Improvement Permit with plat valid without expiration. Improvement Permit with site plan valid for sixty months. Authorization to Construct is valid for a period equal to that of Improvement Permit – not to exceed sixty months.

Signed: Danny M. Lippard date 3-4-05

Improvement Permit by: Christopher M. Sherrill, REHS date 2-28-05

Authorization to Construct by: Christopher M. Sherrill, REHS date 2-28-05

Installed by: DAVID YOUNTZ

Operation Permit by: STEVE HEDRICK date 2-9-06

Existing System Inspection by: date

HEALTH DEPT. COPY: WHITE OWNER COPY (FINAL): YELLOW OWNER COPY (INITIAL): PINK