IREDELL COUNTY HEALTH DEPARTMENT

STATESVILLE 704-878-5305 (01) MOORESVILLE 704-664-5281

IMPROVEMENT PERMIT / AUTHORIZATION TO CONSTRUCT / OPERATION PERMIT / EXISTING SYSTEM INSPECTION

PERMIT# 11595B PIN# ~~4810-17-0237.001~~ 4810-16-2641 DATE 12/29/03

OWNER OR CONTRACTOR W. Thomas Cheatham PHONE: Business — Home (704) 876-0240

ADDRESS 162 Horsemans Drive Statesville, N.C. 28625

LOCATION Hwy 115N, @ mtn. View Rd, @ Cattleman Rd, @ Horsemans Drive to end, turn @, into pasture (~1,300ft off Rd)

SUBDIVISION — BLOCK / SECTION — LOT — LOT AREA 2.410 Acres SITE CLASS. PS DESIGN FLOW 240 L.T.A.R. .30 gpd/ft²

Septic Tank: 4000 Gallons; STB 794 Date 10-6-03
Pump Tank: — Gallons; PT — Date —
Pump Make: — Model — Serial No. —
Nitrification Field: No Fields 1 Square Feet 800 Linear Feet 270'
No Lines 3 @ 90' Trench Width 36" Max Trench Bottom Depth 30" Gravel Depth 12"

☒ New System ☐ Repair System Type: I, (II) III, IV, V, VI
System Description: Gravity, Conventional
Repair System Description: Gravity, Conventional
Maintenance Agreement Required: ☐ Yes ☐ No

☒ House/Mod. Home No. Bedrooms 1
☐ Mobile Home No. Bathrooms 1
☐ Business No. Employees —
☐ Other


Water Supply: ☒ Individual ☐ Public ☐ Community

☒ Slab ☐ Crawl Space ☐ Basement w/plumbing ☐ Basement wo/plumbing

Comments:/Conditions: ① Keep well 100ft From ST+ Septic lines ② Install lines on Contours ③ maintain proper setbacks

Comments:/Conditions ① Zabel Filter ② #57 stone

INITIAL SITE SKETCH (Scale 1" = 100')

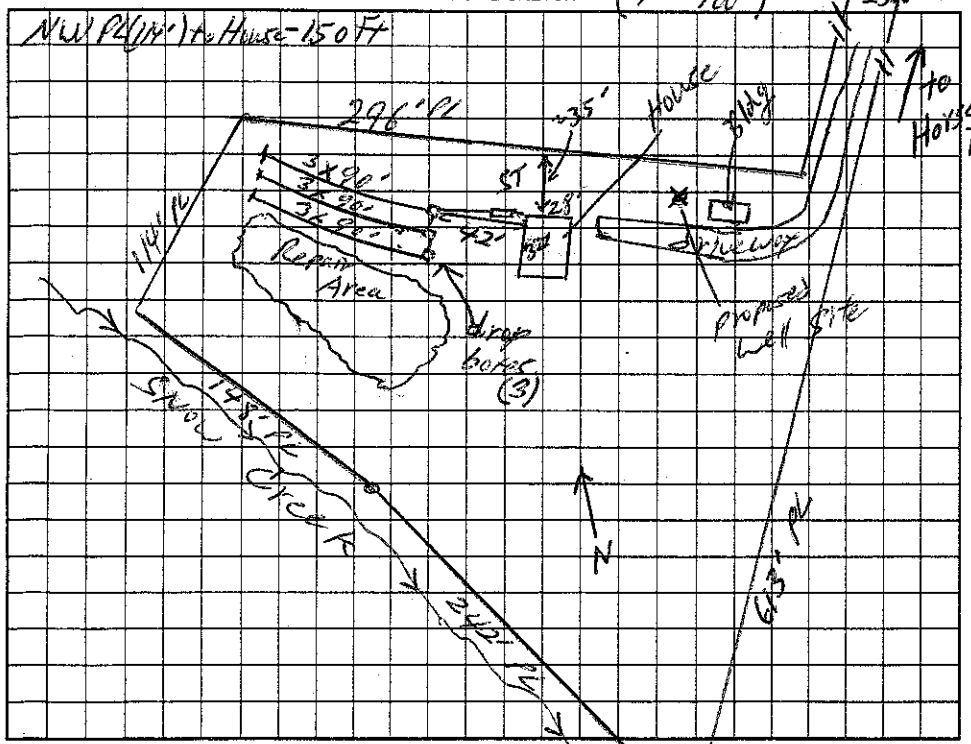

AS BUILT SKETCH

SYSTEM INSTALLED ACCORDING TO INITIAL SITE SKETCH

Permit can be suspended or revoked if any false information is supplied toward securing the permit/any unauthorized changes are made to the site/any unauthorized changes are made in the installation of the system. Improvement Permit with plat valid without expiration. Improvement Permit with site plan valid for sixty months. Authorization to Construct is valid for a period equal to that of Improvement Permit – not to exceed sixty months.

Signed: Wilkin Thomas Cheatham date 12/30/03 Installed by: Marty Tucker

Improvement Permit by: William O. Johnson date 12/30/03 Operation Permit by: Christopher M. Merrill, RS date 1-15-04

Authorization to Construct by: William O. Johnson date 12/30/03 Existing System Inspection by: — date —

HEALTH DEPT. COPY: WHITE OWNER COPY (FINAL): YELLOW OWNER COPY (INITIAL): PINK