IREDELL COUNTY HEALTH DEPARTMENT

STATESVILLE 704-878-5305 MOORESVILLE 704-664-5281

IMPROVEMENT PERMIT / CERTIFICATE OF COMPLETION / OPERATION PERMIT / EXISTING SYSTEM INSPECTION

PROPERTY DESCRIPTION NO. 23530 DATE 4-25-96 TAX MAP NO. PART OF 14M-A-85 Watershed: ☐ Yes ☐ No

OWNER OR CONTRACTOR LES VANDERMARK PHONE: Business Home 876-0900

ADDRESS 300 CATTLEMANS ROAD, STATESVILLE, NC 28677

LOCATION NC 115N TL DAMASCUS CH. RD, TR CATTLEMANS ROAD, CROSS CREEK, DRIVE ON LEFT, BACK OFF ROAD

SUBDIVISION BLOCK / SECTION LOT LOT AREA SITE CLASS. PS DESIGN FLOW 360 L.T.A.R. 0.40 GPD/FT2

Septic Tank: 1000 Gallons; STB 1017 Date 2-6-98
Pump Tank: Gallons; PT Date
Pump Make: Model Serial No.
Nitrification Field: No Fields 1 Square Feet 900 Linear Feet 300
No Lines 5 Trench Width 36" Max Trench Bottom Depth 18-36" Gravel Depth 12"

☑ New System ☐ Repair System Type: I (II) III IV V VI
System Description: CONVENTIONAL GRAVITY
Repair System Description: CONV. GRAVITY
Maintenance Agreement Required: ☐ Yes ☑ No

☐ House/Mod. Home ☐ Mobile Home ☐ Business ☐ Other
No. Bedrooms 3 No. Bathrooms 2 No. Employees


☐ Slab ☑ Crawl Space ☐ Basement w/plumbing ☐ Basement wo/plumbing

Water Supply: ☑ Individual ☐ Community ☐ Public WELL


Comments: KEEP WELL MINIMUM 100' FROM SYSTEM

Comments:

INITIAL SITE SKETCH

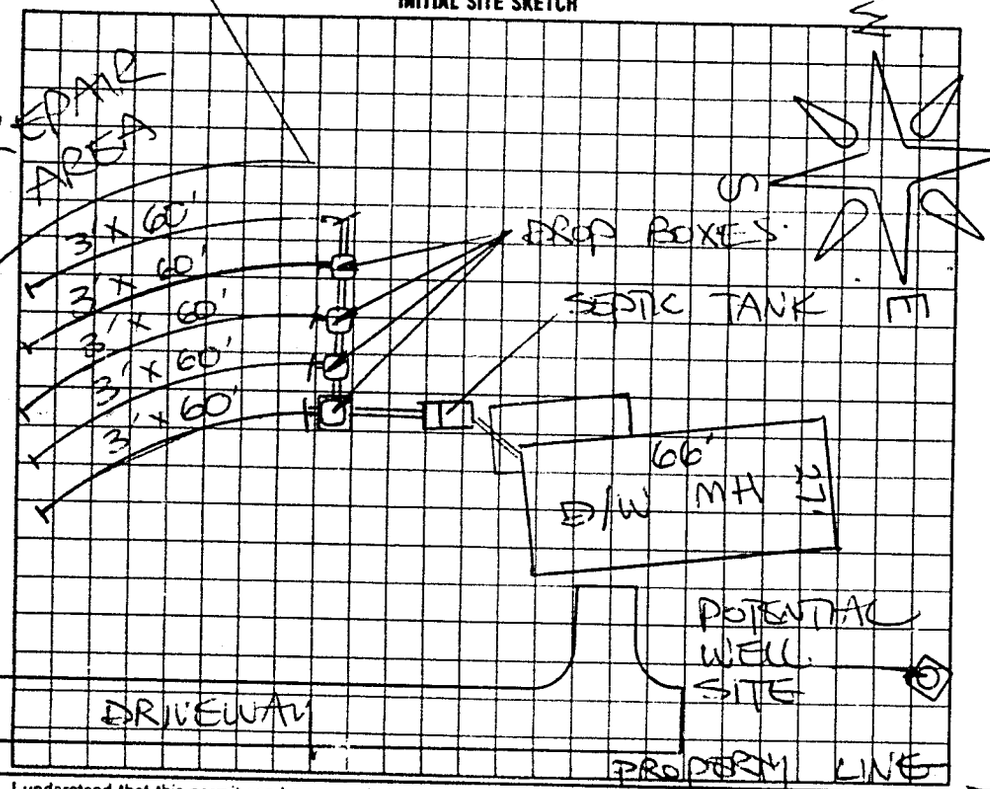

AS BUILT SKETCH

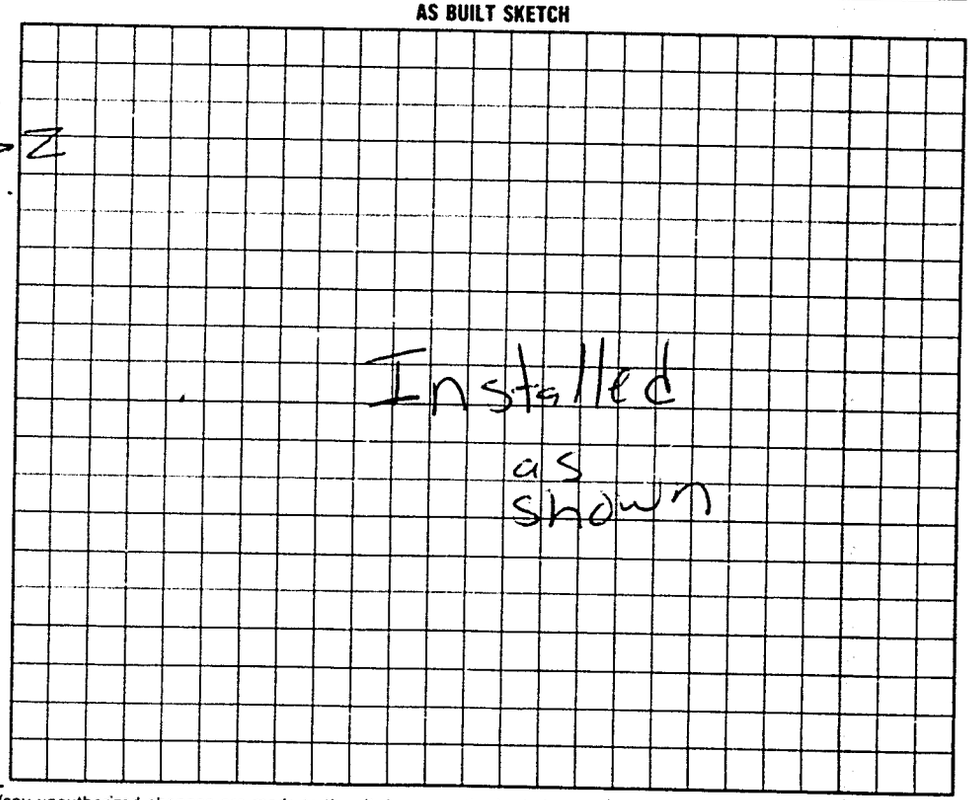

I understand that this permit can be suspended or revoked if any false information is supplied toward securing the permit/any unauthorized changes are made to the site/any unauthorized changes are made in the installation of the system.

AUTHORIZATION TO CONSTRUCT IS VALID FIVE (5) YEARS FROM DATE OF ISSUANCE. IMPROVEMENT PERMIT HAS NO EXPIRATION DATE

Signed: ~~T.C.~~ Thomas C. Hoots, II

Improvement Permit by: STEVE HEDRICK date 4-26-96

AUTHORIZATION TO CONSTRUCT

~~Existing System Inspection~~ by: STEVE HEDRICK date 4-26-96

Installed by: A-1

~~Certificate of Completion~~ by: date

Operation Permit by: date 4-7-98

HEALTH DEPT COPY WHITE INSPECTION COPY (FINAL) GREEN OWNER COPY (FINAL) YELLOW INSPECTION COPY (INITIAL) PINK OWNER COPY (INITIAL) GOLD