9:00

IREDELL COUNTY HEALTH DEPARTMENT

Statesville Office (704) 878-5305 Mooresville Office (704) 660-3625 PERMIT # 177011

IMPROVEMENT PERMIT / AUTHORIZATION TO CONSTRUCT / OPERATION PERMIT / EXISTING SYSTEM

PIN # 4810274680

APPLICANT: Michael Nevers APPLICANT ADDRESS: 136 Mitchell Trail

SITE ADDRESS: 284 Cattlemans Rd. PHONE: 704-592-7632 ALT. PHONE: N/A

SITE DIRECTIONS: Hwy 115 N TL Damascus Ch. Rd. TR Cattlemans Rd.


SUBDIVISION: Howard Shoemaker SECTION: N/A LOT # 5 LOT AREA: 4.6 acres DESIGN FLOW: 240 gpd L.T.A.R.: 0.25

Septic Tank	1000 (gal)	STB	620	Date	5-23-12	☑ New System ☐ Repair ☐ Expansion	System Type: I II ☒ IV V VI	☑ Residence	No. Bedrooms 2
Pump Tank	(gal)	PT		Date		System Description:	25% Reduction	☐ Business	No. Persons
Pump Make		Model		Serial #		Repair System Description:	25% Reduction	☐ Other	No. Employees
# Nitrification Fields	1	# Lines	3	Linear Ft:	240	Maintenance Agreement Required:	☐ YES ☑ NO	☐ Slab	☑ Crawl Space
Trench Width	36"	Max. Trench Bottom Depth	33"	Gravel Depth	N/A	☑ GRAVITY	☐ PRESSURE	☐ Basement w/plumbing	☐ Basement w/o plumbing


Water Supply: ☑ Private ☐ Public ☐ Community

Comments / Conditions: Install a 25% Reduction system on contour with serial distribution

INITIAL SITE SKETCH

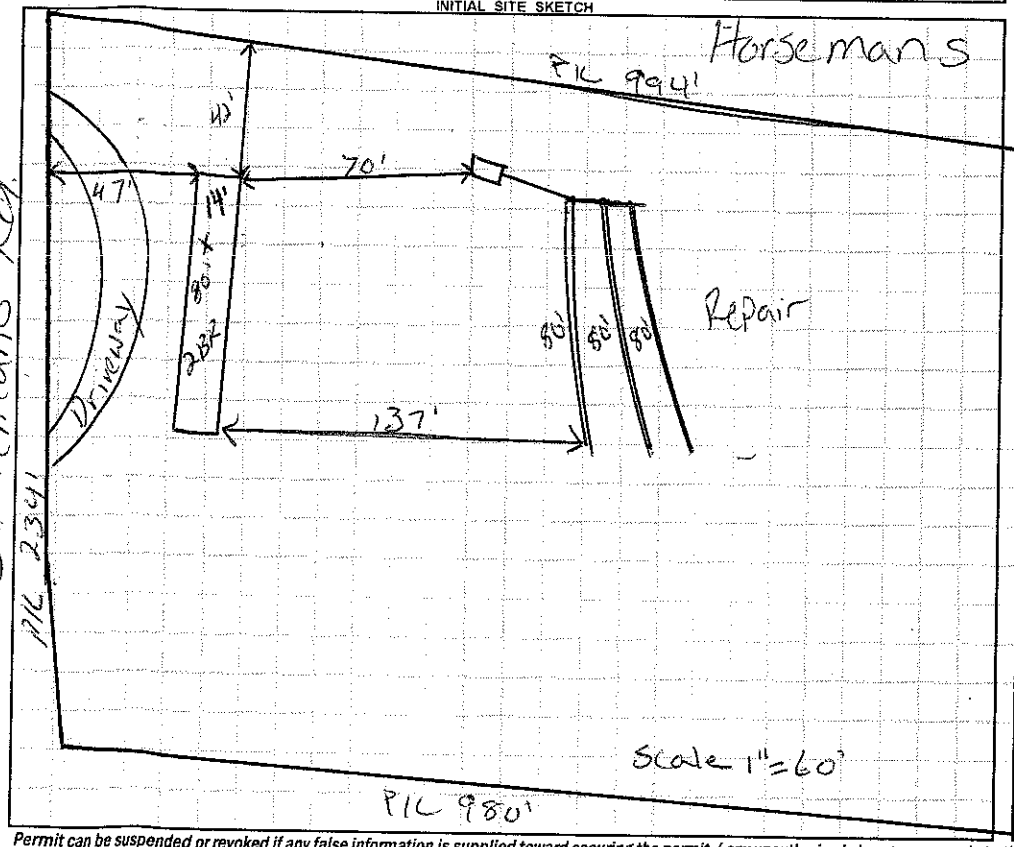

AS BUILT SKETCH

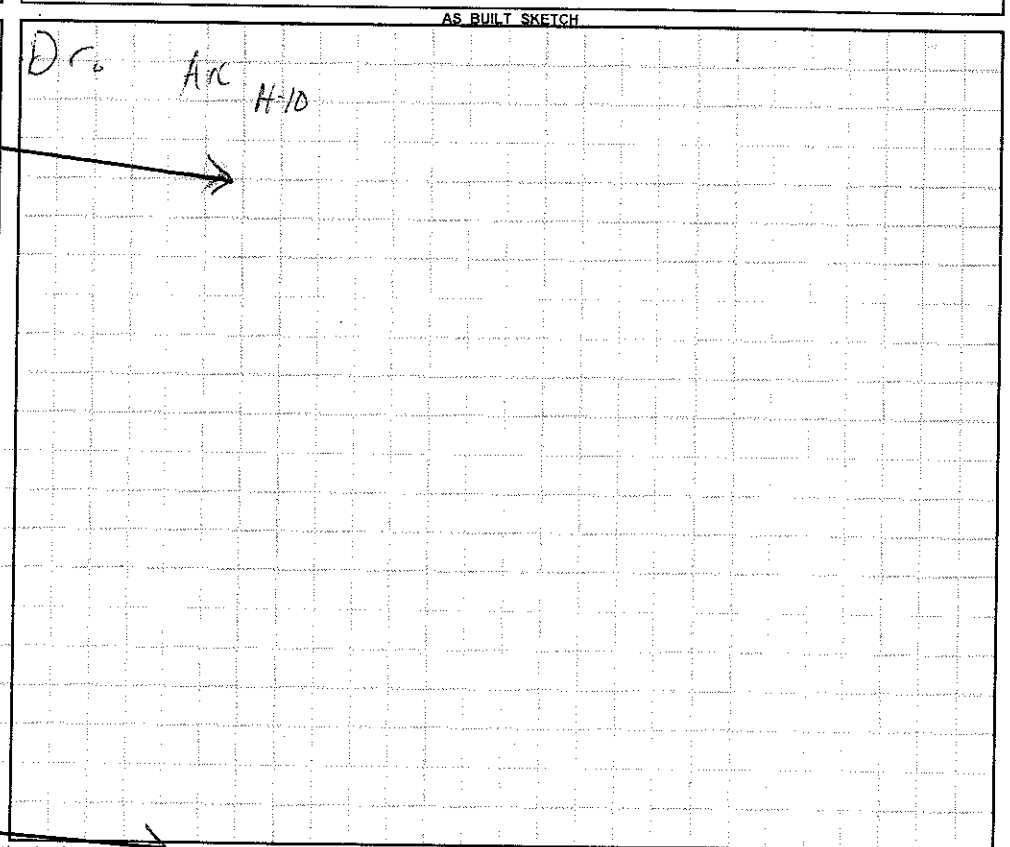

Permit can be suspended or revoked if any false information is supplied toward securing the permit / any unauthorized changes are made to the site / any unauthorized changes are made in the installation of the system. **CONTACT A LOCATOR SERVICE PRIOR TO ANY EXCAVATION**

☐ **IMPROVEMENT PERMIT** ***with plat*** *valid without expiration.* ☑ **IMPROVEMENT PERMIT** ***with site plan*** *valid for 60 mos.* ☑ **AUTHORIZATION TO CONSTRUCT** *valid for period equal to IMPROVEMENT PERMIT--not to exceed 60 mo.*

Owner / Applicant Signature: Michael Nevers Date: 2/19/2013 Installed by: Madison Grading

IMPROVEMENT PERMIT by: Justin Henderson Date: 2-18-13 OPERATION PERMIT by: [signature] Date: 3-8-13

AUTHORIZATION TO CONSTRUCT by: Justin Henderson Date: 2-18-13 Existing System Inspected by: Date:

Health Dept. Copy - WHITE Applicant (Final Approval) - YELLOW Applicant (Conditional Approval) - PINK