IREDELL COUNTY HEALTH DEPARTMENT

STATESVILLE 704-878-5305 MOORESVILLE 704-664-5281

IMPROVEMENT PERMIT / AUTHORIZATION TO CONSTRUCT / OPERATION PERMIT / EXISTING SYSTEM INSPECTION

PERMIT# 077342 PIN# 4719 39 6821 DATE 11-6-98

OWNER OR CONTRACTOR TRACY L. BARNES PHONE: Business Home

ADDRESS 156 BARNES AIRSHIP DRIVE STATESVILLE NC 28625

LOCATION NC115N, TL DAMASCUS, TL OLD ARBOR, TL BARNES AIRSHIP TO END PAST BUSINESS 0.4 mi on (L)

SUBDIVISION BLOCK / SECTION LOT LOT AREA AMPLE SITE CLASS PS DESIGN FLOW 100 L.T.A.R. 0.256 GPD/FT²

Septic Tank: 1000 Gallons; STB 1012 Date 12-28-99

Pump Tank: Gallons; PT Date

Pump Make: Model Serial No.

Nitrification Field: No Fields 1 Square Feet 400 Linear Feet 133

No Lines TWO Trench Width 36" Max Trench Bottom Depth 36"

✓ New System ☐ Repair System Type: I II III IV V VI

System Description: CONVENTIONAL GRAVITY

Repair System Description: PUMP TO CONVENTIONAL

Maintenance Agreement Required: Yes ✓ No

Gravel Depth 12" ✓ Slab Crawl Space Basement w/plumbing Basement wo/plumbing

☐ House/Mod. Home No. Bedrooms

☐ Mobile Home No. Bathrooms 1

☐ Business No. Employees


✓ Other POOL BATH HOUSE

Water Supply: ☐ Individual ☐ Public ☐ Community


Comments/Conditions: ① INSTALL SUBSURFACE INTERCEPT DRAINAGE DITCH MINIMUM 10 FEET ABOVE SYSTEM AS SHOWN BEGINNING 48" DEEP OUT TO DAYLIGHT ② INSTALL SURFACE DRAINAGE DITCH ABOVE SUBSURFACE DITCH AS SHOWN.

Comments/Conditions: ① SEPTIC TANK WITH RISERS INSTALLED WITH "POLY LOK" FILTER AT OUTLET ② TANK & LINES INSPECTED 3-11-99. DRAINAGE DITCHES REMAIN TO BE INSTALLED

INITIAL SITE SKETCH

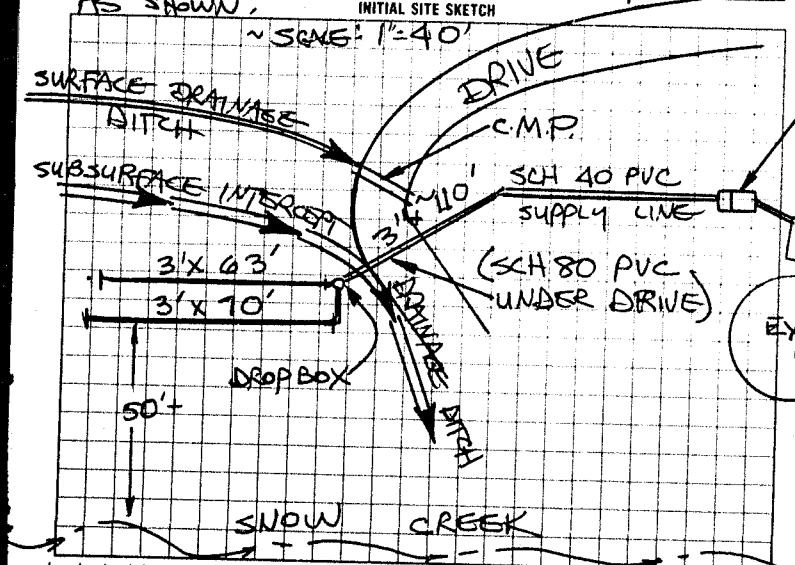

AS BUILT SKETCH

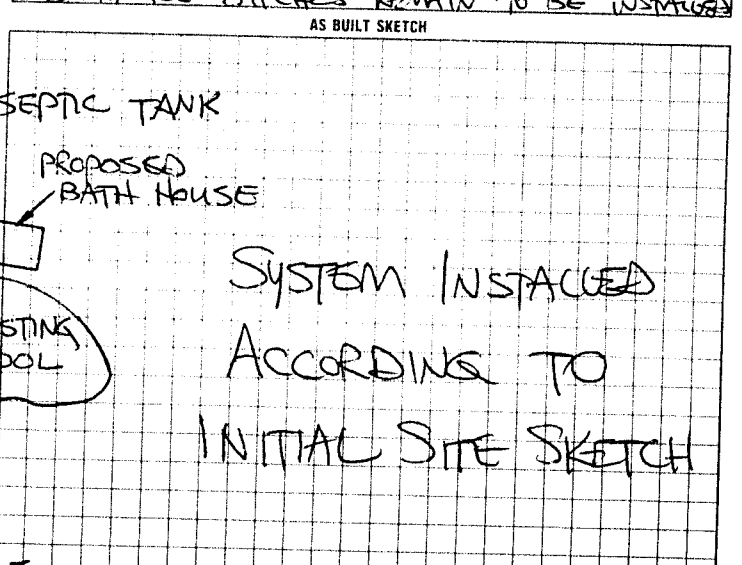

I understand that this permit can be suspended or revoked if any false information is supplied toward securing the permit/any unauthorized changes are made to the site/any unauthorized changes are made in the installation of the system. Improvement Permit with plat valid without expiration. Improvement Permit with site plan valid for sixty months. Authorization to Construct is valid for a period equal to that of Improvement Permit – not to exceed sixty months.

Signed: + Tracy Barnes date 11-6-98

Improvement Permit by: STEVE HEDRICK date 11-6-98

Authorization to Construct by: STEVE HEDRICK date 11-6-98

Installed by: KENNY MADISON

Operation Permit by: STEVE HEDRICK date 5-4-99

Existing System Inspection by: date

HEALTH DEPT. COPY: WHITE INSPECTION COPY (FINAL) GREEN OWNER COPY (FINAL) YELLOW INSPECTION COPY (INITIAL) PINK OWNER COPY (INITIAL) GOLD