IREDELL COUNTY HEALTH DEPARTMENT

STATESVILLE 704-878-5305 MOORESVILLE 704-664-5281

IMPROVEMENT PERMIT / AUTHORIZATION TO CONSTRUCT / OPERATION PERMIT / EXISTING SYSTEM INSPECTION

PERMIT# 073149 PIN# 4719396821 DATE 5-15-98

OWNER OR CONTRACTOR TRACY BARNES PHONE: Business Home 876-2378

ADDRESS 156 BARNES AIRSHIP DRIVE, STATESVILLE NC 28625

LOCATION NC 115 N, TL DAMASCUS CH. RD, TL BARNES AIRSHIP DRIVE, AT END NORTH ALONG SNOW CREEK 2ND DWELLING

SUBDIVISION BLOCK / SECTION LOT LOT AREA 39.71 ACRES SITE CLASS. PS DESIGN FLOW 240 L.T.A.R. 0.80 GPD/FT²

Septic Tank: 1000 Gallons; STB 160 Date 5-22-98

Pump Tank: Gallons; PT Date

Pump Make: Model Serial No.

Nitrification Field: No Fields 1 Square Feet 300 Linear Feet 100

No Lines TWO Trench Width 36" Max Trench Bottom Depth 36" Gravel Depth 12"

☑ New System ☐ Repair System Type: I (II) III, IV, V, VI

System Description: CONVENTIONAL GRAVITY

Repair System Description: CONVENTIONAL GRAVITY

Maintenance Agreement Required: ☐ Yes ☑ No

☑ House/Mod. Home ☐ Mobile Home ☐ Business ☐ Other

No. Bedrooms 2 No. Bathrooms 1 No. Employees

☐ Slab ☐ Crawl Space ☐ Basement w/plumbing ☐ Basement wo/plumbing


Water Supply: ☑ Individual ☐ Public ☐ Community WELL

Comments:/Conditions:

Comments:/Conditions:

~SCALE: 1"=40'

INITIAL SITE SKETCH

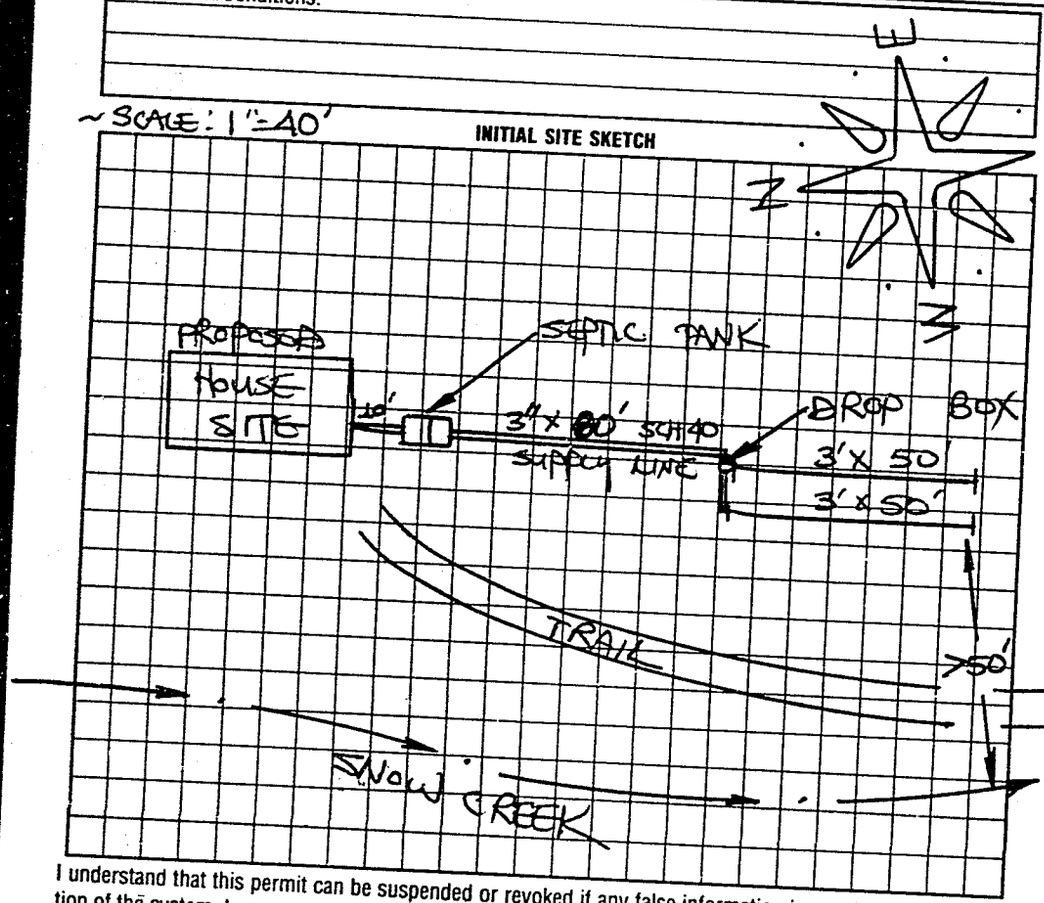

AS BUILT SKETCH

SYSTEM INSTALLED ACCORDING TO INITAL SITE SKETCH

I understand that this permit can be suspended or revoked if any false information is supplied toward securing the permit/any unauthorized changes are made to the site/any unauthorized changes are made in the installation of the system. Improvement Permit with plat valid without expiration. Improvement Permit with site plan valid for sixty months. Authorization to Construct is valid for a period equal to that of Improvement Permit – not to exceed sixty months.

Signed: X Tracy Barnes date 5-15-98

Improvement Permit by: STEVE HEDRICK date 5-15-98

Authorization to Construct by: STEVE HEDRICK date 5-15-98

Installed by: SHANE JARRETT GRADING

Operation Permit by: STEVE HEDRICK date 7-10-98

Existing System Inspection by: date

HEALTH DEPT. COPY: WHITE INSPECTION COPY (FINAL): GREEN OWNER COPY (FINAL): YELLOW INSPECTION COPY (INITIAL): PINK OWNER COPY (INITIAL): GOLD