MD

IREDELL COUNTY HEALTH DEPARTMENT

Statesville Office - Central Permitting (704) 878-5305 Mooresville Office (704) 660-3625


PRIVATE DRINKING WATER WELL PERMIT # 219277 **PIN #** 4810-31-9807 **Type of Permit (circle one):** (New) Repair Abandonment

APPLICANT NAME: William D. Barger Jr. ADDRESS: 310 Damascus Church Rd. Statesville, NC 28625 PHONE: 704-978-8344


DIRECTIONS TO SITE: Rt 115 N from Statesville → Left on Damascus Church Rd → Lot on Right

SITE ADDRESS: √310 Damascus Church Rd Statesville, NC SUBDIVISION: James + Velma Deal Estates SECTION/LOT: 1+2

Scale 1"=100' Initial Site Sketch

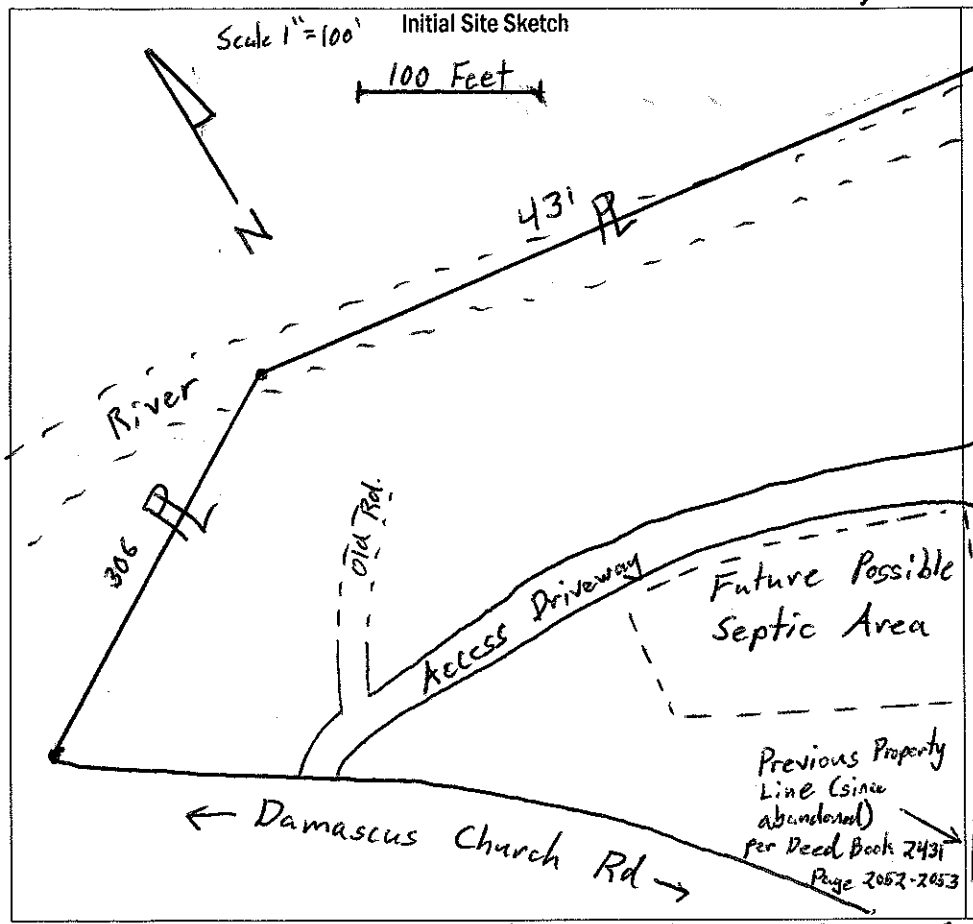

"As-Built" Sketch

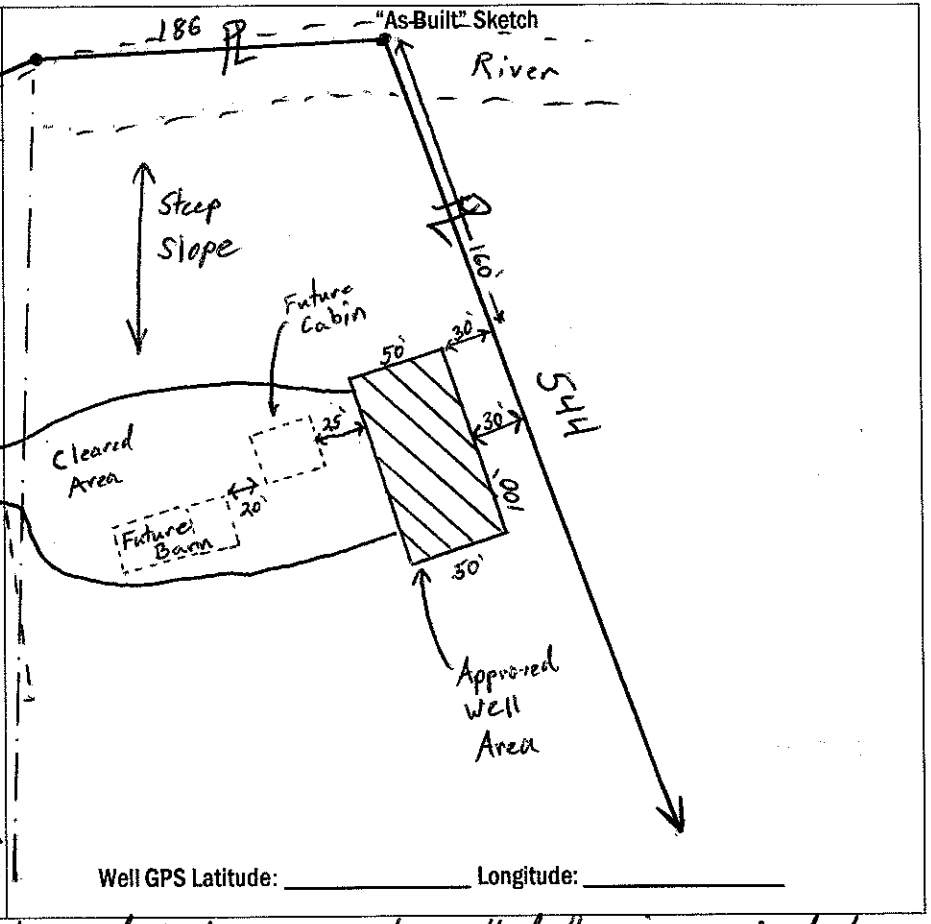

Well GPS Latitude: _____ Longitude: _____

PERMIT CONDITIONS/COMMENTS: Follow all N.C. well rules. Due to future desired improvements, well driller is required to have a pre-construction meeting with owner/applicant to ensure well meets all necessary setbacks.

WELL PERMIT ISSUED BY: Tom Shuck DATE: 7-20-16 (Permit is valid for 5 years from date issued. This permit may be revoked if it is determined there has been a material change in any fact or circumstance upon which the permit is issued. Actions of the employees of the Iredell County Health Department shall in no way be taken as a guarantee that this well will produce water of any particular quantity or quality or for any amount of time. Employees of the Iredell County Health Department assume no liability for any damages, either direct or consequential which may be caused by this well.)

Well Contractor: Mid-South Well & Pump CONTRACTOR CERT #: 2344 GROUT INSPECTION BY: _____ DATE: 7/29/16

OR CERTIFICATION OF GROUT NOT WITNESSED BY DEPT: _____ DATE: _____ WELL HEAD INSPECTION BY: _____ DATE: 8/2/16

WELL HEAD INSPECTION (check when completed): GROUT TO GROUND SURFACE ☑ WELL CONTRACTOR ID PLATE ☑ PUMP INSTALLER ID PLATE ☑ SAMPLE PORT ☑

ACCESS PORT / VENT ☒ WELL SEAL ☒ WELL HEAD 12 INCHES / PITLESS ADAPTOR 8 INCHES ABOVE GRADE ☒

CERTIFICATE OF COMPLETION BY: _____ DATE: 8/2/16 WATER SAMPLES BY: _____ DATE: _____

Attachments: Form GW-1a (required except for abandonment) ☒ Form GW-30 ☐ Water Sample Results ☐ Plat ☐

Health Dept. Copy - White Applicant Certificate of Completion - Yellow Applicant Well Construction Permit - Pink