BELL COUNTY HEALTH DEPARTMENT
ROVEMENT PERMIT / CERTIFICATE OF COMPLETION / OPERATION PERMIT / EXISTING SYSTEM INSPE


STATESVILLE 704-878-5305 MOORESVILLE 704-664-5281

19276 DATE 8/29/95 TAX MAP NO 14M-A-132 (PART)
OR CONTRACTOR TAMMY STEVENSON PHONE: Business Home 873-3955
S 138 FAIR TOSCANE, STVL, NC 28677
NC HSN, TL MTN VIEW RD, TL CATTLEMAN'S ROAD PS 2ND DRIVEWAY (NEW) LOT
TOCO 794 Date 7/7/94 OR AREA 4 ACRES SOIL CLASS DESIGN FLOW 360 GPD 0.35
1 1035' 345
3 36 Slope 18-36" Depth 12
System: Repair System Type: Conventional Other
System Description: CONVENTIONAL SEPTIC SYSTEM
Repair System Description:
Maintenance Agreement Req: Yes No
Home/Mobile Home No. Bedrooms 3 No. Bathrooms 1
Business No. Employees
Other FUTURE 3BR HOUSE
Crawl Space Basement w/plumbing Basement w/o plumbing

C KEEP SYSTEM MINIMUM 5' FROM MH 10' M. PROPERTY LINE, 100' FROM WELL @ FALL LINES AS SHOWN ON CONTOUR, NO LESS THAN 36", 9' APART MINIMUM ON CENTER

IN THE SITE

AS BUILT SKETCH

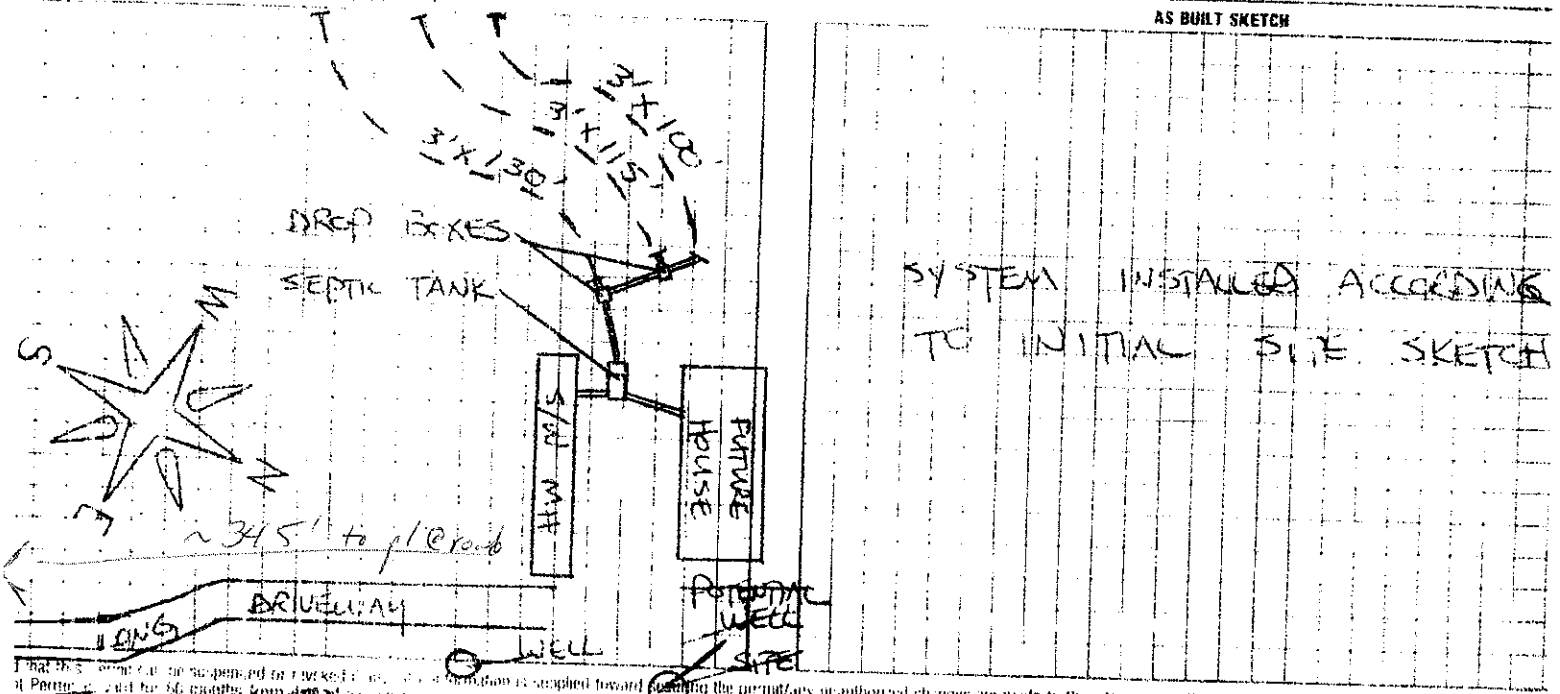

That this ... suspended or revoked ... Operation is accepted ... Permit ... void for 60 months from date of issuance.

Permit ... STEVE HENDRICK date 8/29/95
Item ... Installed by WES LYTON
date Certificate of Completion by STEVE HENDRICK date 9/7
Operation Permit by date

OWNER COPY (FINAL) YELLOW INSPECTION COPY (INITIAL) PINK

JAN. 20, 1989 19:04