IREDELL COUNTY HEALTH DEPARTMENT

STATESVILLE 704-878-5305 MOORESVILLE 704-664-5281

IMPROVEMENT PERMIT / CERTIFICATE OF COMPLETION / OPERATION PERMIT / EXISTING SYSTEM INSPECTION

PROPERTY DESCRIPTION NO. 19276 DATE 8/29/94 TAX MAP NO. 14M-A-132 (PART) Watershed: ☐ Yes ☑ No

OWNER OR CONTRACTOR TOMMY STEADMAN PHONE: Business Home 873-3955

ADDRESS 138 PARK TERRACE, STVL, NC 28677

LOCATION NC 115N, TL MTN VIEW RD, TL CATTLEMAN'S ROAD 2ND DRIVEWAY (NEW) ON (R)

SUBDIVISION BLOCK / SECTION LOT LOT AREA 4 ACRES SITE CLASS. PS DESIGN FLOW 360 L.T.A.R. 0.35 GPD/FT²

Septic Tank: 1000 Gallons; STB 794 Date 7/1/94

Pump Tank: Gallons; PT Date

Pump Make: Model Serial No.

Nitrification Field: No Fields Square Feet 1035 Linear Feet 345

No Lines 3 Trench Width 36" Max Trench Bottom Depth 18-36" Gravel Depth 12"

☑ New System ☐ Repair System Type: I, (II), III, IV, V, VI

System Description: CONVENTIONAL GRAVITY

Repair System Description: CONV. GRAVITY

Maintenance Agreement Required: ☐ Yes ☑ No

☐ House/Mod. Home No. Bedrooms 2

☑ Mobile Home No. Bathrooms 1

☐ Business No. Employees

☐ Other FUTURE 3BR HOUSE


☐ Slab ☑ Crawl Space ☐ Basement w/plumbing ☐ Basement wo/plumbing

Water Supply: ☑ Individual ☐ Community ☐ Public WELL

Comments: ① KEEP SYSTEM MINIMUM 5' FROM MH 10' FROM PROPERTY LINE, 100' FROM WELL ② INSTALL LINES AS SHOWN ON CONTOUR, NO DEEPER THAN 36", 9' APART MINIMUM ON CENTER.

Comments:

INITIAL SITE SKETCH

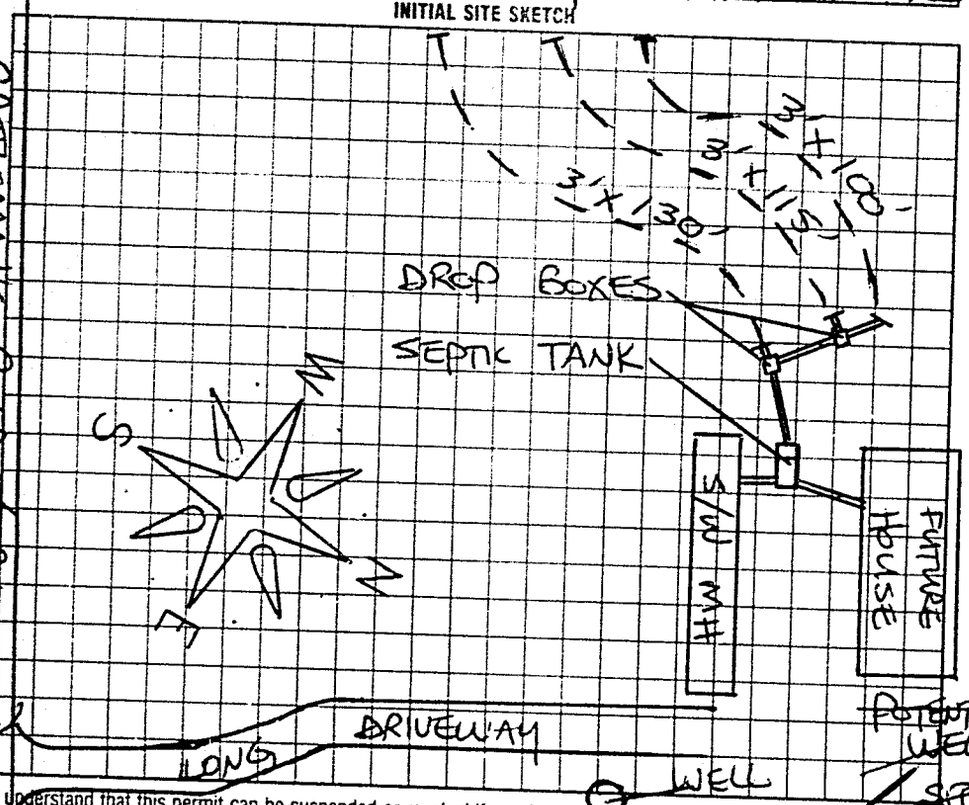

AS BUILT SKETCH

SYSTEM INSTALLED ACCORDING TO INITAL SITE SKETCH

I understand that this permit can be suspended or revoked if any false information is supplied toward securing the permit/any unauthorized changes are made to the site/any unauthorized changes are made in the installation of the system. Improvement Permit is valid for 60 months from date of issuance.

Signed: Tommy Steadman

Improvement Permit by: STEVE HEDRICK date 8/29/95

Existing System Inspection by: date

Installed by: WES LYTON

Certificate of Completion by: STEVE HEDRICK date 9/7/94

Operation Permit by: date

HEALTH DEPT. COPY: WHITE INSPECTION COPY (FINAL): GREEN OWNER COPY (FINAL): YELLOW INSPECTION COPY (INITIAL): PINK OWNER COPY (INITIAL): GOLD