IREDELL COUNTY HEALTH DEPARTMENT

STATESVILLE 704-878-5305 MOORESVILLE 704-664-5281

IMPROVEMENT PERMIT / AUTHORIZATION TO CONSTRUCT / OPERATION PERMIT / EXISTING SYSTEM INSPECTION

PERMIT# 133262 PIN# 4810392069 DATE 1-20-06

OWNER OR CONTRACTOR Thomas & Kara Steadman PHONE: Business 704 876 6444 Home 704 902 4431

ADDRESS 204 Cattlemans Rd

LOCATION Hwy 115N, (R) on Mountainview, (L) on Cattlemans Rd, 2nd on right

SUBDIVISION n/a BLOCK / SECTION ____ LOT ____ LOT AREA 3.95 SITE CLASS. PS DESIGN FLOW 360 L.T.A.R. Existing

Septic Tank: 1000 Existing Gallons; STB ____ Date ____

Pump Tank: ____ Gallons; PT ____ Date ____

Pump Make: ____ Model ____ Serial No. ____

Nitrification Field: No Fields ____ Square Feet ____ Linear Feet ____

No Lines ____ Trench Width ____ Max Trench Bottom Depth ____ Gravel Depth ____

☐ New System ☐ Repair System Type: I, (II), III, IV, V, VI

System Description: Conventional Gravity

Repair System Description: ____

Maintenance Agreement Required: ☐ Yes ☐ No

☒ House/Mod. Home No. Bedrooms 3

☐ Mobile Home No. Bathrooms ____

☐ Business No. Employees ____

☐ Other ____

☐ Slab ☐ Crawl Space ☐ Basement w/plumbing ☐ Basement wo/plumbing


Water Supply: ☒ Individual ☐ Public ☐ Community

Comments:/Conditions:


Mobile Home to be disconnected from existing system

Comments:/Conditions:

INITIAL SITE SKETCH

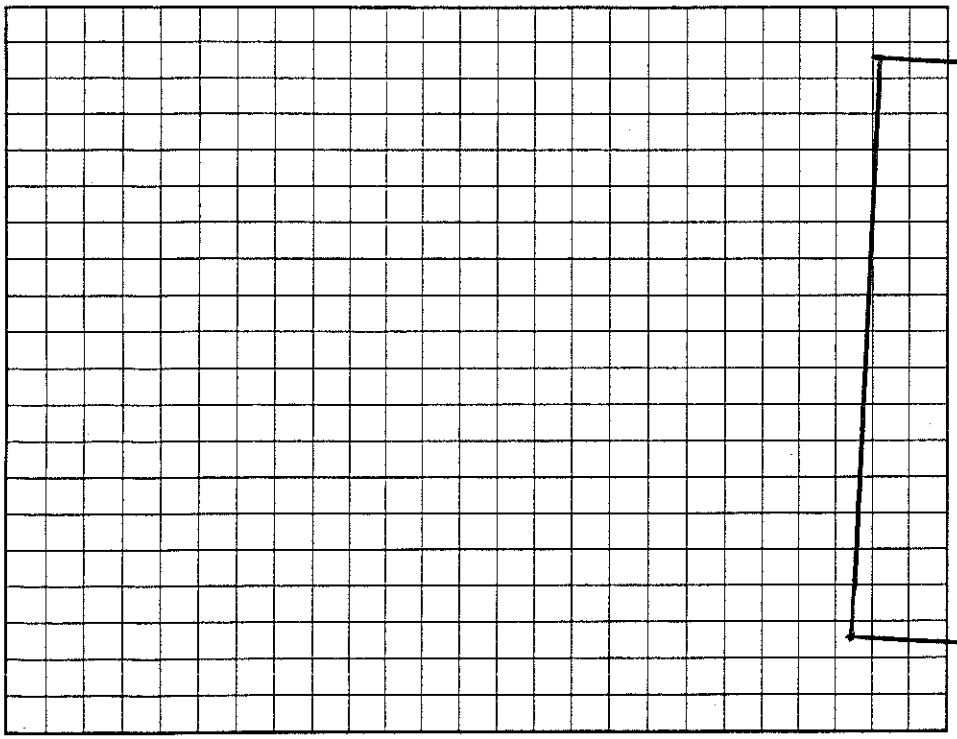

AS BUILT SKETCH

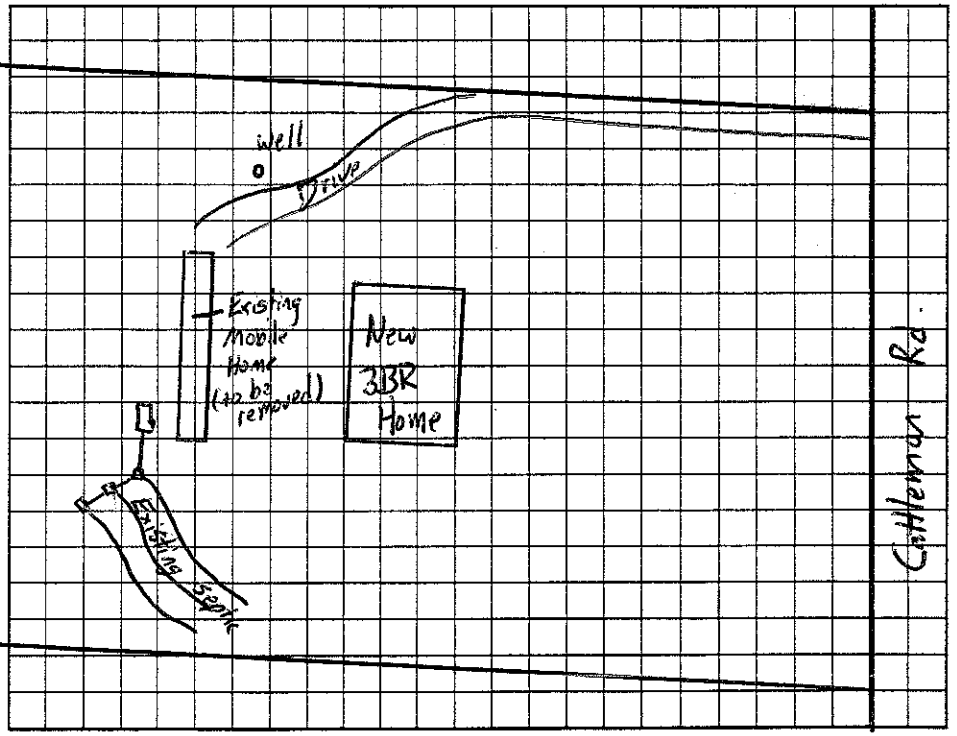

Permit can be suspended or revoked if any false information is supplied toward securing the permit/any unauthorized changes are made to the site/any unauthorized changes are made in the installation of the system. Improvement Permit with plat valid without expiration. Improvement Permit with site plan valid for sixty months. Authorization to Construct is valid for a period equal to that of Improvement Permit – not to exceed sixty months.

Signed: James Steadman date 1-20-06

Improvement Permit by: ____ date ____

Authorization to Construct by: ____ date ____

Installed by: Wes Lytton (9/95)

Operation Permit by: ____ date ____

Existing System Inspection by: James Steadman date 1-20-06

HEALTH DEPT. COPY: WHITE OWNER COPY (FINAL): YELLOW OWNER COPY (INITIAL): PINK