ICHD–ENVIRONMENTAL HEALTH DIVISION

Statesville Office (704) 878-5305 Mooresville Office (704) 660-3625 PERMIT # AP-301592

SEPTIC IMPROVEMENT PERMIT / AUTHORIZATION TO CONSTRUCT / OPERATION PERMIT / EXISTING SYSTEM

PIN # 4810-52-3479.135

APPLICANT/OWNER: William Line APPLICANT ADDRESS: 140 Mason Lane Statesville, NC

SITE ADDRESS: 135 Mason Lane Statesville, NC 28625 PHONE: 704-682-0460 ALT. PHONE 704-902-1210

SITE DIRECTIONS: Rt 115 N → Damascus Church Rd → Mason Lane → on Left SAP CONTROLLED: ☐ YES ☒ NO


SUBDIVISION: — SECTION: — LOT # — LOT AREA: 11.053 acres DESIGN FLOW: 240 GPD L.T.A.R.: Existing

Septic Tank	(gal)	STB	Date	☐ New System	☐ Repair	☐ Expansion	System Type: I II III IV V VI	☒ Residence	No. Bedrooms 3
Pump Tank	(gal)	PT	Date	System Description:				☐ Business	No. Persons 4
Pump Make	Model		Serial #	Repair System Description: Existing				☐ Other	No. Employees
# Nitrification Fields	# Lines		Linear Ft:	Maintenance Agreement Required:	☐ YES	☒ NO		☐ Slab	☐ Crawl Space
Trench Width	Trench Bottom Depth(Low side)		Gravel Depth		☒ GRAVITY	☐ PRESSURE		☐ Basement w/plumbing	☐ Basement w/o plumbing

Water Supply: ☒ Private Existing ☐ Public ☐ Community

Comments / Conditions: Recommend having system pumped every 3-5 years. No foundation drains for mobile home allowed. Keep at least 5 feet from any septic components.

INITIAL SITE SKETCH

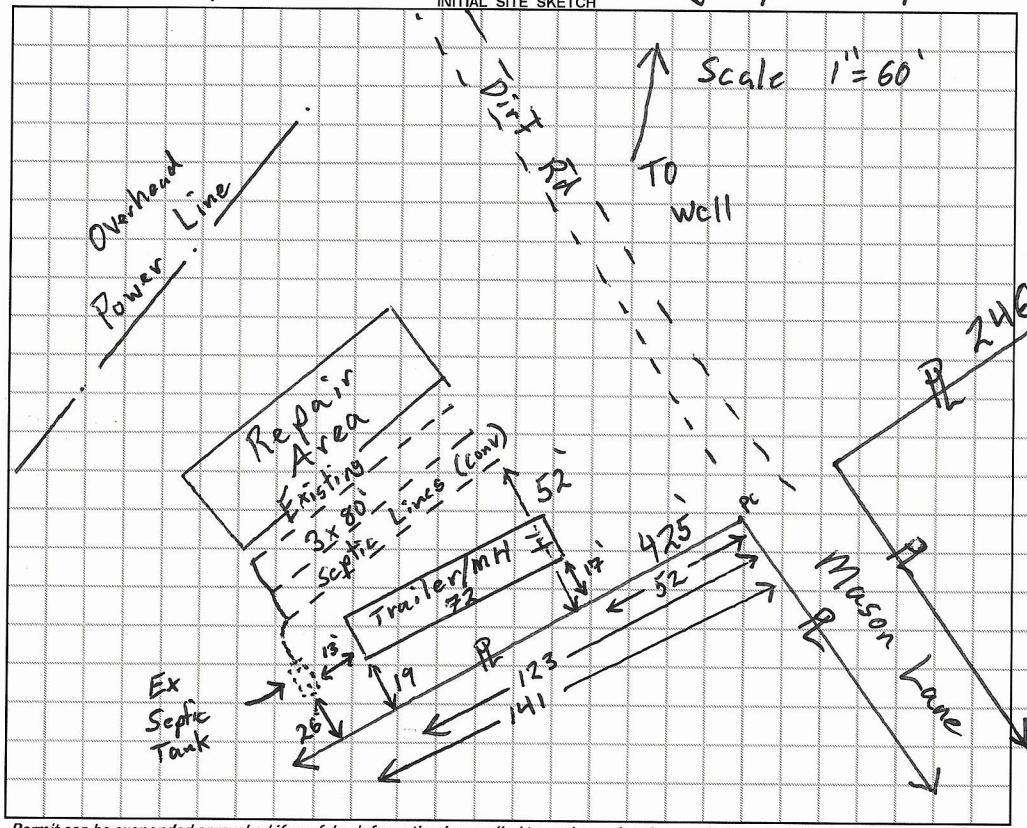

AS BUILT SKETCH

Permit can be suspended or revoked if any false information is supplied toward securing the permit / any unauthorized changes are made to the site / any unauthorized changes are made in the installation of the system. **CONTACT A LOCATOR SERVICE PRIOR TO ANY EXCAVATION**

☐ **IMPROVEMENT PERMIT** *with plat valid without expiration.* ☐ **IMPROVEMENT PERMIT** *with site plan valid for 60 mos.* ☐ **AUTHORIZATION TO CONSTRUCT** *valid for period equal to IMPROVEMENT PERMIT--not to exceed 60 mo.*

Owner / Applicant Signature: William E Line Date: 11-21- Installed by: —

IMPROVEMENT PERMIT by: — Date: — OPERATION PERMIT by: — Date: —

AUTHORIZATION TO CONSTRUCT by: — Date: — Existing System Inspected by: Tom Rhuck Date: 11/8/2019

FOR SEPTIC FINAL INSPECTION: CALL 704-664-3703 between 8am-9am the day the inspection is needed. Be sure to speak with an inpsector to confirm your inspection time.

RECEIVED OCT 8 2019

APPLICATION MUST BE FILLED OUT COMPLETELY & BE LEGIBLE OR IT WILL NOT BE PROCESSED

Paid $250.00

Iredell County Health Department – Environmental Health Division

PAGE 1: *APPLICATION FORM*

AP-301592

Application For: ( ) New Well Permit ( ) Well Repair Permit ( ) Well Abandonment
( ) Septic Improvement Permit ( ) Authorization to Construct (X) Existing System Inspection ( ) Septic System Repair

THE ABOVE PERMIT DOCUMENTS WILL BECOME INVALID IF INFORMATION PROVIDED ON THIS APPLICATION IS FALSIFIED OR CHANGED, OR IF THE SITE IS ALTERED. THE IMPROVEMENT PERMIT IS VALID FOR EITHER 60 MONTHS OR WITHOUT EXPIRATION DEPENDING UPON DOCUMENTATION SUBMITTED. APPLICATION WITH SITE PLAN 60 MONTHS, APPLICATION WITH COMPLETE, SCALED PLAT WITHOUT EXPIRATION. SEE 15A NCAC 18A .1937(f) FOR DETAILS.

Page 2: *Site Plan Worksheet* form MUST accompany this application

The following optional attachments may also be submitted: ( ) Survey Plat, scaled no more than 1 inch = 60 feet
Place an (X) beside whichever is submitted if applicable ( ) Custom Site Plan, scaled no more than 1 inch = 60 feet

Applicant Information: (PRINT CLEARLY)

Applicant Name: William E Line Address: 140 Mason Ln Zip: 28625
Applicant Email: ernie.line@yahoo.com Phone: 704-682-0460 Alt. Phone: 704-902-1210
Owner Name: William E Line Address: _____ Zip: _____
Owner Email: _____ Phone: _____ Alt. Phone: _____

Property Information:

Street Address: 135 Mason Ln
Subdivision Name: _____ Section/Phase: _____ Lot Number: _____
Driving Directions: Hwy 115 North To Damascus Rd. Damascus Rd to Mason Ln

Site Development Information: *(check or complete ALL that apply*

( ) New Single Family Residence
( ) New Multi-Family Residence
(X) Accessory Building
( ) Bedroom(s) Addition
( ) Repair to failing septic system ___ Tank ___ Drain lines Describe Problem: _____
Maximum Number of Bedrooms: 2
Maximum Number of Occupants: 4
( ) Swimming Pool
( ) Other Addition/Structure: _____
Non-Residential Site Development: Type of Business: _____
Square Footage of Building: _____ Max. Number of Employees: _____ Max. Number of Seats/Beds/Other: _____

CHECK FOUNDATION TYPE

(X) Crawl Space Foundation
( ) Concrete Slab Foundation
( ) Basement with Plumbing
( ) Basement without Plumbing

Water Supply: ( ) Replacement Well – Reason: _____
(X) Multi-connection Well Number of Houses: 1 Number of Persons: 4
( ) New Well (X) Existing Well ( ) Community Well ( ) City Water ( ) Other Public Water

Desired Septic System Type: *(you may rank in order of preference)* Year existing system installed: 4-16-2001
( ) No Preference ( ) Alternative ( ) Conventional ( ) Innovative ( ) Modified Conventional ( ) Other: _____

Please answer the following to the best of your ability:

( ) Yes (X) No Does the site contain any jurisdictional wetlands?
( ) Yes (X) No Is any non-domestic sewage (i.e. industrial) to be generated?
( ) Yes (X) No Is the site subject to approval by any other public agency?


I have read this application and certify that the information provided herein is true, complete, and correct. Authorized county and state officials are granted right of entry to conduct necessary inspections to determine compliance with applicable laws and rules. I understand that I am solely responsible for the proper identification and labeling of all property lines and corners and making the site accessible so that a complete site evaluation can be performed.

Signature: William E Line 8-21-19
Property owner or owner's legal representative signature (SIGNATURE REQUIRED) DATE

IREDELL COUNTY DEPARTMENT of ENVIRONMENTAL HEALTH

SITE PLAN WORKSHEET

SEE THE "SAMPLE SITE PLAN" BELOW. *INCOMPLETE SITE PLANS WILL BE RETURNED TO YOU FOR COMPLETION AND MAY RESULT IN A DELAY IN THE ISSUANCE OF YOUR SEPTIC SYSTEM OR WELL PERMIT!!!*

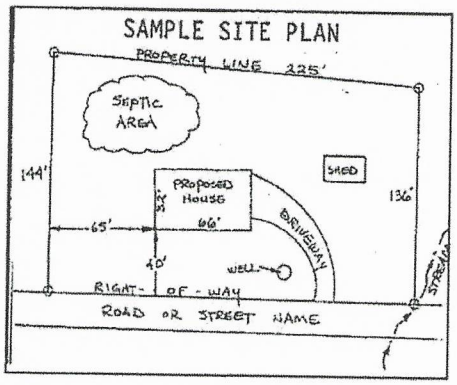

Place an (X) beside each item as you complete the site plan:


( ) Property Line measurements are clearly identified
( ) All proposed structures are indicated
( ) Front and side setbacks from property line
( ) Preferred driveway location
( ) Preferred well location
( ) Preferred septic system location
( ) North arrow, or other sufficient indicator of direction

Circle N/A on the following if appropriate:

Location of septic systems and wells within 100' of your property	N/A
Location of easements and rights of ways on your property	N/A
Location of any designated wetlands on the property	N/A


USE THIS SPACE TO DRAW YOUR SITE PLAN

Show: proposed house or business footprint, wells, water lines, patios, pools and decks, and any other item that will occupy space on the site

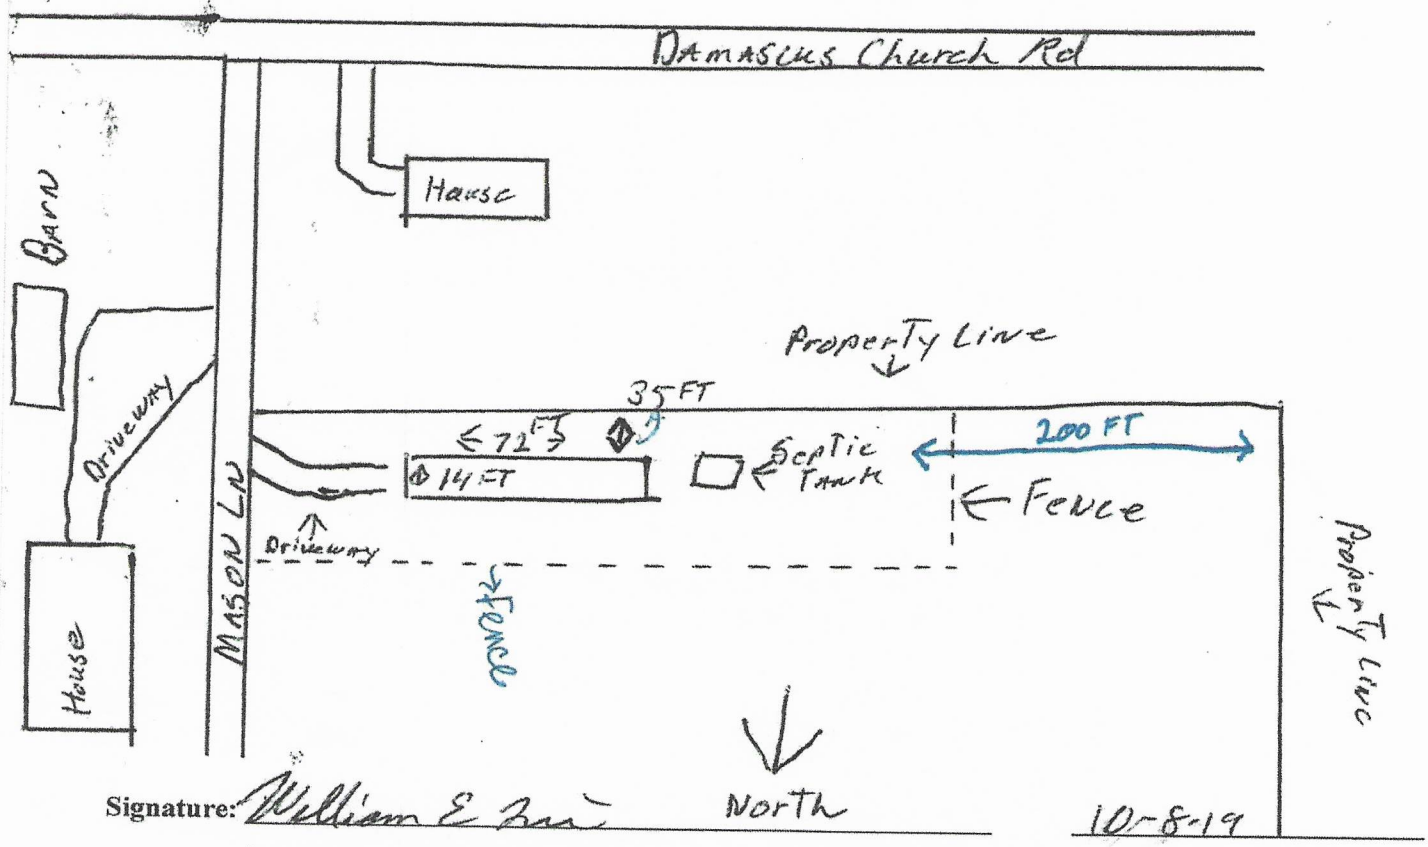


Property owner or owner's legal representative signature (SIGNATURE REQUIRED) **DATE**

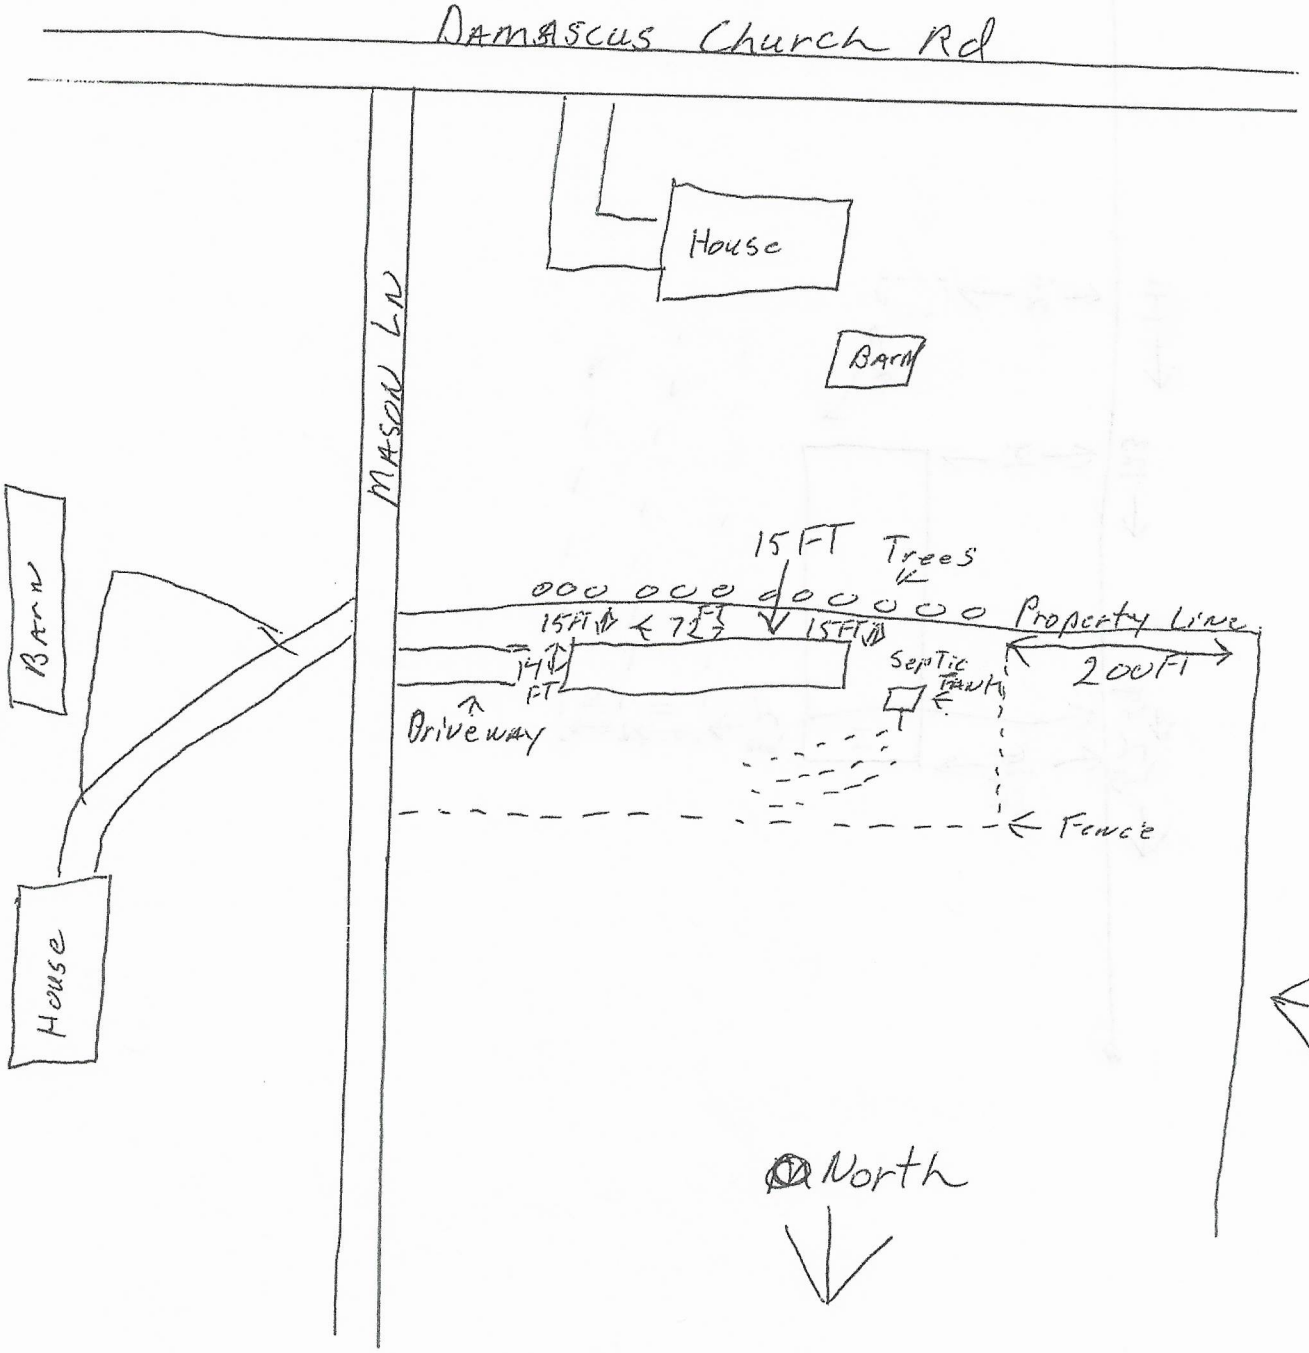

William E Zain

10-23-19

IREDELL COUNTY HEALTH DEPARTMENT

STATESVILLE 704-878-5305 MOORESVILLE 704-664-5281

IMPROVEMENT PERMIT / AUTHORIZATION TO CONSTRUCT / OPERATION PERMIT / EXISTING SYSTEM INSPECTION

PERMIT# 095185 PIN# 4810 52 3479 DATE 4/16/01

OWNER OR CONTRACTOR BRYAN ERVIN PHONE: Business ______ Home ______

ADDRESS 326 PROSPECT ROAD, STATESVILLE, NC 28625

LOCATION 115 N, (L) DAMASCUS CH. RD. 1/4 mi (R) MASON LN. ON (L)

SUBDIVISION ______ BLOCK / SECTION ______ LOT ______ LOT AREA 1.11 AC. SITE CLASS. PS DESIGN FLOW 240 GPD L.T.A.R. .35

Septic Tank: 1000 Gallons: STB 1012 Date 12-19-00
Pump Tank: ______ Gallons: PT ______ Date ______
Pump Make: ______ Model ______ Serial No. ______
Nitrification Field: No Fields 1 Square Feet 720' Linear Feet 240'
No Lines 3 Trench Width 3' Max Trench Bottom Depth 36" Gravel Depth 12"

☑ New System ☐ Repair System Type: I, (II), III, IV, V, VI
System Description: CONVENTIONAL
Repair System Description: CONVENTIONAL
Maintenance Agreement Required: ☐ Yes ☑ No

☐ House/Mod. Home ☑ Mobile Home ☐ Business ☐ Other ______
No. Bedrooms 2 No. Bathrooms 2 No. Employees ______


☐ Slab ☑ Crawl Space ☐ Basement w/plumbing ☐ Basement wo/plumbing

Water Supply: ☑ Individual ☐ Public ☐ Community
SHARED

Comments/Conditions: (1) INSTALL DRAINLINES UNIFORM AND ON CONTOUR (2) NO CUTTING OR FILLING OVER DRAINFIELD/REPAIR AREAS (3) KEEP ALL DRAINS AWAY FROM DRAINFIELD/REPAIR AREAS (4) MAINTAIN NOTED SETBACKS

Comments/Conditions: 4/30/01 - TURNING HOUSE PARALLEL TO P/L, NOT CHANGING DRAINFIELD (T.S.)
* SEPTIC TANK WITH MARKER INSTALLED USING "POLYLOK" FILTER

INITIAL SITE SKETCH * NOT TO SCALE

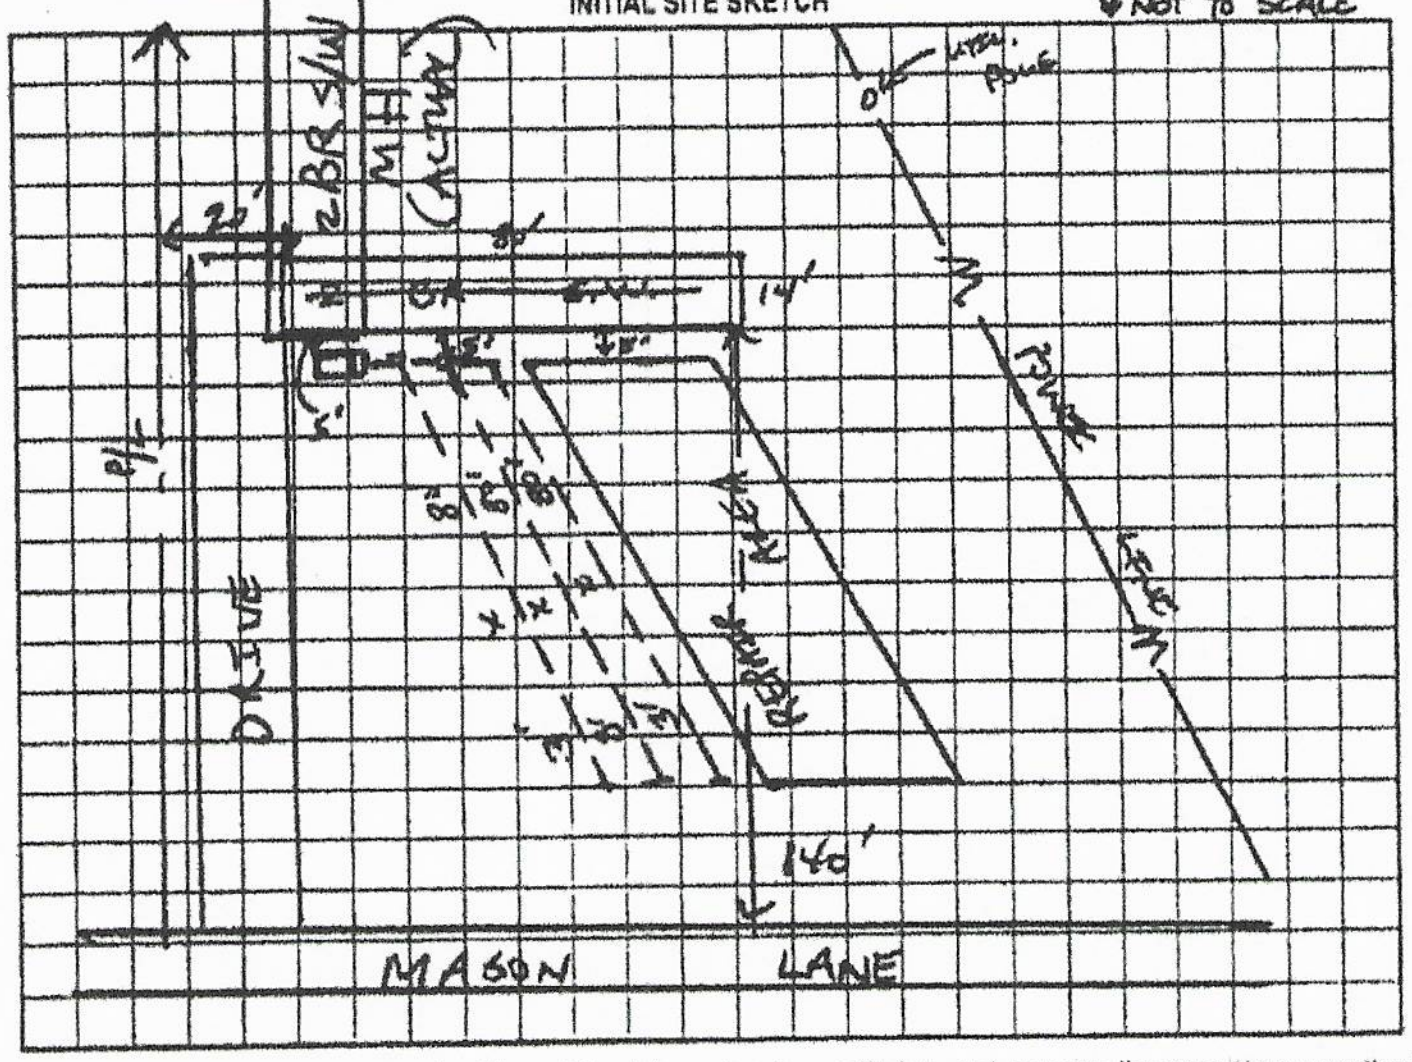

AS BUILT SKETCH

SYSTEM INSTALLED ACCORDING TO INITIAL SITE SKETCH (SLIGHTLY OUT OF CONTOUR)

Permit can be suspended or revoked if any false information is supplied toward securing the permit/any unauthorized changes are made to the site/any unauthorized changes are made in the installation of the system. Improvement Permit with plat valid without expiration. Improvement Permit with site plan valid for sixty months. Authorization to Construct is valid for a period equal to that of Improvement Permit – not to exceed sixty months.

Signed: Bryan L. Ervin date 4/16/01
Improvement Permit by: Dusty Shinn date 4/16/01
Authorization to Construct by: Dusty Shinn date 4/16/01

Installed by: BRENT GALLIHER
Operation Permit by: STEVE HEDRICK date 5-15-01
Existing System Inspection by: ______ date ______

HEALTH DEPT. COPY WHITE OWNER COPY (FINAL) YELLOW OWNER COPY (INITIAL) PINK

IREDELL COUNTY DEPARTMENT OF ENVIRONMENTAL HEALTH

DOCUMENTATION TO AUTHORIZE AN OWNER'S LEGAL REPRESENTATIVE

(Check and sign only ONE of the options below)

1. *** APPLICANT AND OWNER ARE THE SAME. *** (*Sign here*) William E Line

Applications for permits require the "signature of the owner or owner's legal representative" (15A NCAC 18A .1937). If the owner does not sign the application himself or herself, they can submit any one of the following documents to designate their legal representative: *Power of Attorney; Real Estate Contract; Estate executor; Bankruptcy trustee; Court ordered guardianship* In the absence of the above documentation, the property owner may provide the local health department with documentation that designates a legal representative. A property owner may:
Complete this form to document his or her legal representative, or provide his or her own form that contains the information in this form. If there are multiple property owners, then all property owners must sign the form that designates a legal representative.
By signing a form that designates a legal representative for purposes of 15A NCAC 18A .1937, the property owner authorizes that representative to act on their behalf in matters pertaining to the application and permitting process, including signing or receiving any application, document or permit. The owner retains full responsibility to meet all permit conditions specified by the local health department.

2. I, William E Line, am the legal owner(s) of the property located at 135 Mason Ln, identified as

PIN (Parcel Identification Number) 4810 52 3479, located in Iredell County, North Carolina.

I do hereby authorize (**print legal representative/company name**) _____,

_____, to act as an agent on my behalf in applying for/signing/obtaining any of the documents described below.

- Application for Improvement Permit (IP) / Authorization to Construct (AC)
- Improvement Permit (IP) / Authorization to Construct (AC)
- Application for soil-site evaluation (new/repair)
- Application/permit for private drinking water well/well abandonment
- Application for Compliance Inspection


I agree to abide by all decisions and/or conditions between the legal representative acting on my behalf and the Iredell County Department of Public Health, Environmental Health Division.

William E Line — Signature of Owner(s)

08-21-19 — Date

Mooresville - Environmental Health
ronda.hart@co.iredell.nc.us
Fax: 704-662-3239
610 E. Center Avenue, Mooresville, NC 28115

Statesville - Environmental Health
adrienne.shea@co.iredell.nc.us
Fax: 704-871-3483
349 N. Center Street, Statesville, NC 28677

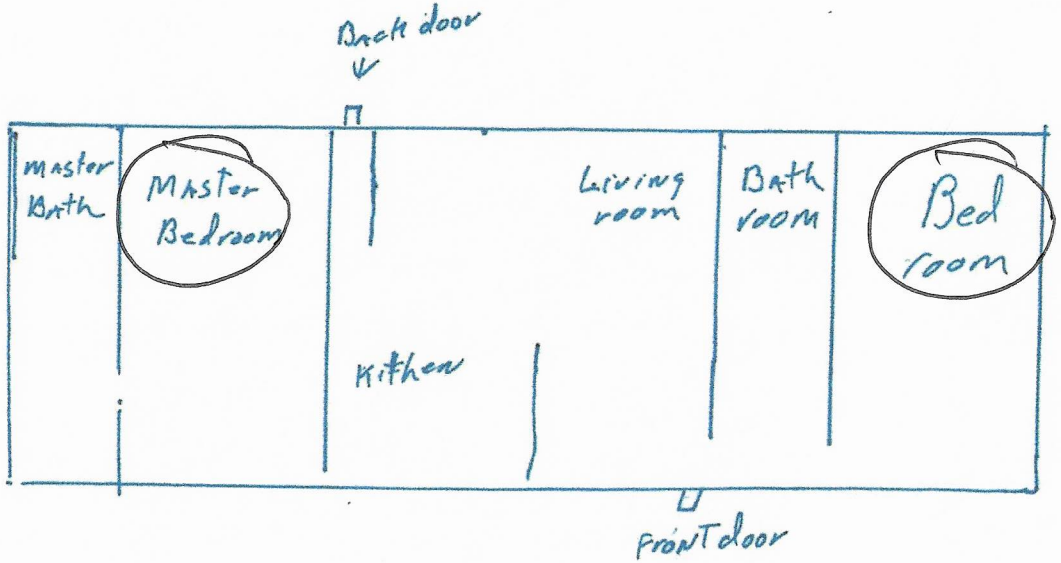

Acknowledgement Of
Plans Submittal ONLY!
Date 11/8/19

Date

William E Zu

10/8/19

IREDELL COUNTY · NC

IREDELL COUNTY

PO Box 788
349 North Center St.
Statesville, NC 28677

APPLICATION NUMBER
301592 Issue Date: 10/08/2019

Permit Type: ZONING RESIDENTIAL

Parcel Number	Street Address	Jurisdiction
4810523479.000	135 MASON LN	IREDELL COUNTY

Owner Information	Applicant Information
Name: LINE WILLIAM+BILLIE Address: Phone: (704)682-0460	Name: LINE WILLIAM+BILLIE Address: Phone:

Use Requested	Zone Code
Single-Wide Mobile Home	RA

Lot Acreage	F Setback	B Setback	L Setback	R Setback	Watershed	Flood Zone
11.053	35	35	15	15	WSIV-PA South Yadkin	NO

Remarks

SW MOBILE HOME

REQUIREMENTS FOR ALL SINGLEWIDE MOBILE HOMES Must meet requirement R10 of the LDC. Must remove the towing apparatus, if it cannot be removed, it shall be screened; Must have a continuous underpinning; Must have 36 square foot front porch constructed within 12 inches of the floor elevation; Must have approved steps at all other secondary entrances and exits; Must face front property line and be no less than 20 degrees from parallel to the front property line. Original home must be removed before Certificate of Occupancy can be approved.

The applicant certifies that there are no deed restrictions, contractual agreements or governmental regulations of any kind that interfere with or prohibit the use of the property or the use for which this permit is requested. The applicant further acknowledges that enforcement of deed restrictions, plat conditions and other contractual agreements will not be undertaken by Iredell County and is the sole responsibility of the affected parties.

_____
Signature of Owner/Contractor


Date: 10/08/2019

Permit Number	000510

TOTAL FEES:	$77.25


ZONING SETBACKS
ZONING SETBACKS FOR REPLACEMENT M/H AT 135 MASON LANE
W. Allison 10/14/19
WILLIAM ALLISON
COUNTY PLANNER
189
172
140
166
135
M/H
15'
35'
35'
15'
EASEMENT
MASON LN
202
240
DAMASCUS CHURCH RD
(1150)
1107
1218
1010
789
194
176
105
622
282
529
299
200
163
100
510
478
352
381
742
746
270
150
340
625
1135
165
33
353
500
425
216
640
543

ZONING DISCLAIMER

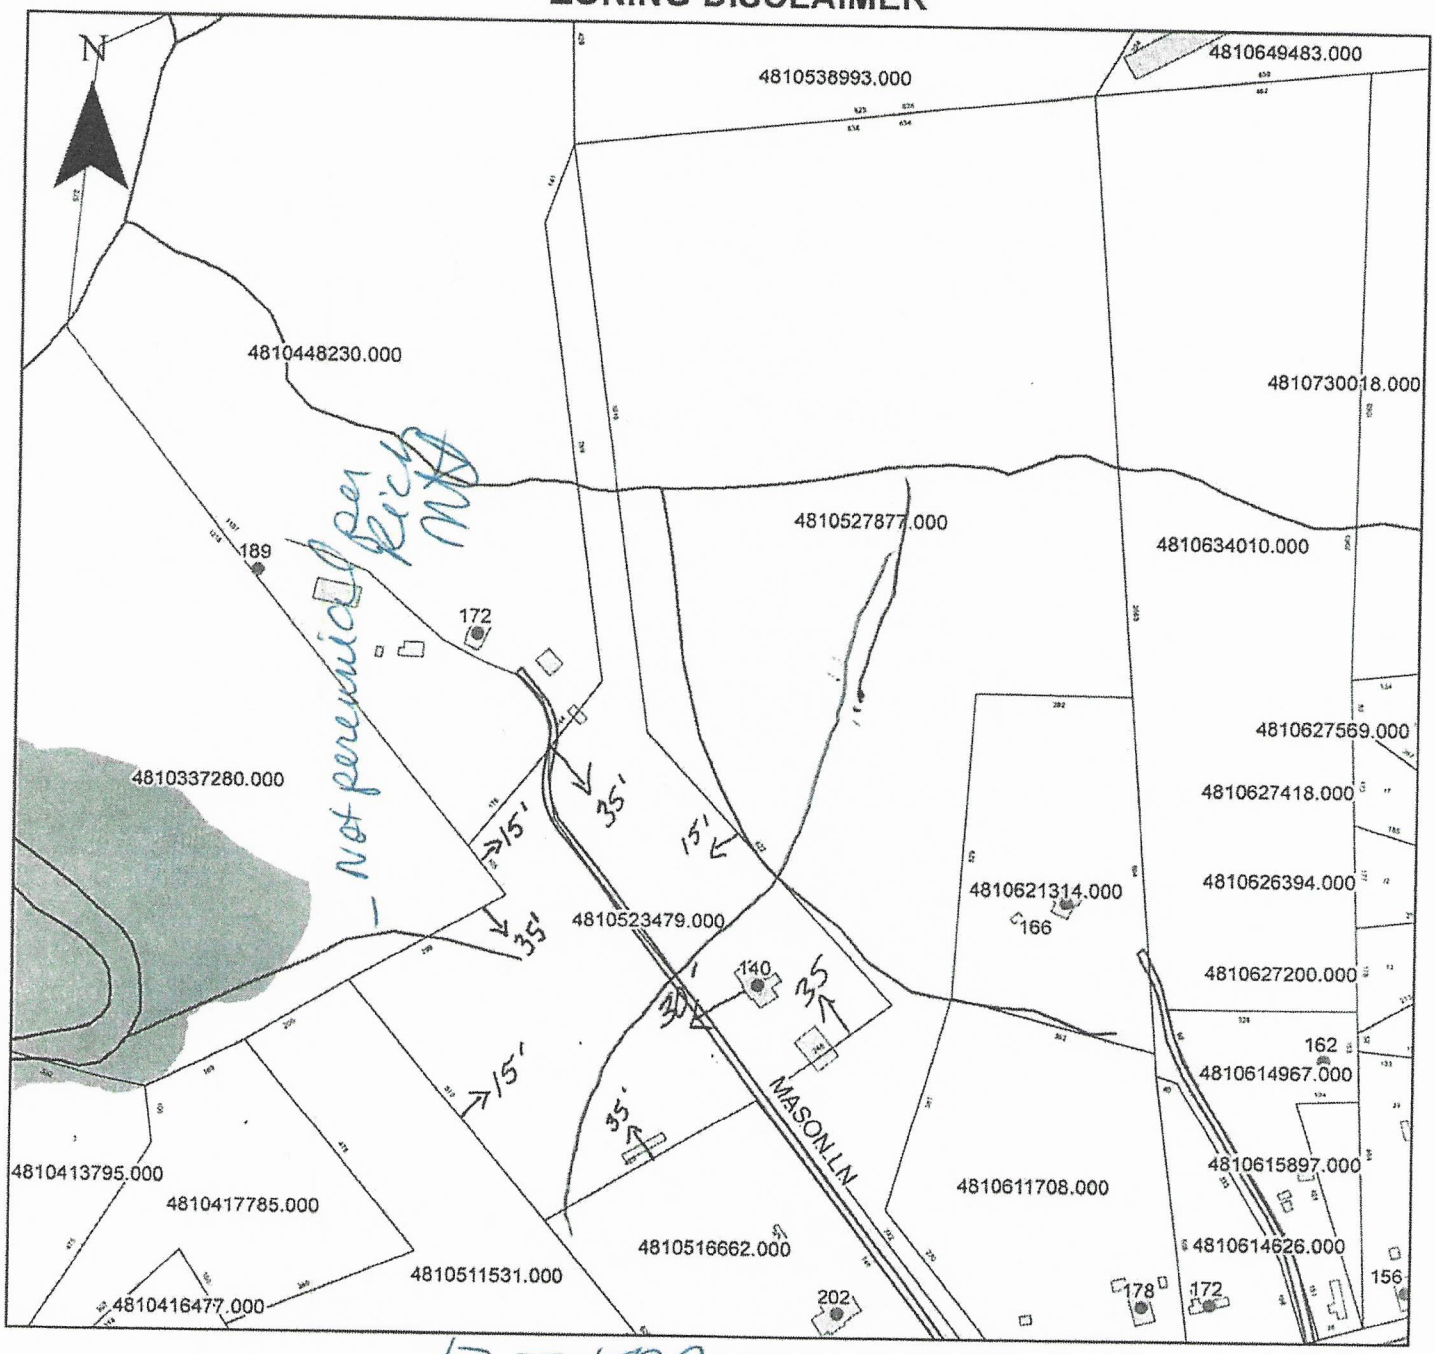

Property Address 135 Mason

The applicant certifies that there are no deed restrictions, contractual agreements or governmental regulations of any kind that interfere with or prohibit the use of the property or the use for which this permit is requested. Applicant further acknowledges that the enforcement of deed restrictions, plat conditions, and other contractual agreements will not be undertaken by Iredell County and is the sole responsibility of the affected parties.

William E Zee

Applicant

Date