IREDELL COUNTY HEALTH DEPARTMENT

STATESVILLE 704-878-5305 MOORESVILLE 704-664-5281 (01)

IMPROVEMENT PERMIT / AUTHORIZATION TO CONSTRUCT / OPERATION PERMIT / EXISTING SYSTEM INSPECTION

PERMIT# 135438 PIN# 4810-61-4222 DATE 5-31-06

OWNER OR APPLICANT JAY MITCHELL PHONE: Business 704-878-5131 Home 704-437-6285

ADDRESS 147 DAMASCUS CH. RD, STATESVILLE, NC 28625

LOCATION NC 115 NORTH, TL DAMASCUS CH ROAD, ON LEFT AT PO BOX #175

SUBDIVISION B.L.A Bryant BLOCK / SECTION ____ LOT 26 LOT AREA 1.711 ACRES SITE CLASS. PS DESIGN FLOW 240 L.T.A.R. EXISTING

Septic Tank: 1000 Gallons: STB ____ Date ____

Pump Tank: ____ Gallons: PT ____ Date ____

Pump Make: ____ Model ____ Serial No. ____

Nitrification Field: No Fields 1 Square Feet ____ Linear Feet EXISTING

No Lines 1 BED Trench Width ____ Max Trench Bottom Depth ____ Gravel Depth EXT

☐ New System ☐ Repair ☐ Expansion, System Type: I (II) III IV V VI

System Description: CONVENTIONAL, GRAVITY

Repair System Description: ____

Maintenance Agreement Required: ☐ Yes ☒ No

☐ Gravity ☐ Pressure

☐ House/Mod. Home ☐ Mobile Home ☐ Business ☐ Other

No. Bedrooms 2 No. Persons ____ No. Employees ____

Water Supply: ☐ Individual ☐ Public ☐ Community SPRING


☐ Slab ☒ Crawl Space ☐ Basement w/plumbing ☐ Basement wo/plumbing

Comments:/Conditions:

Comments:/Conditions: SYSTEM UNDERSIZED ACCORDING TO INITIAL SITE SKETCH

INITIAL SITE SKETCH

AS BUILT SKETCH

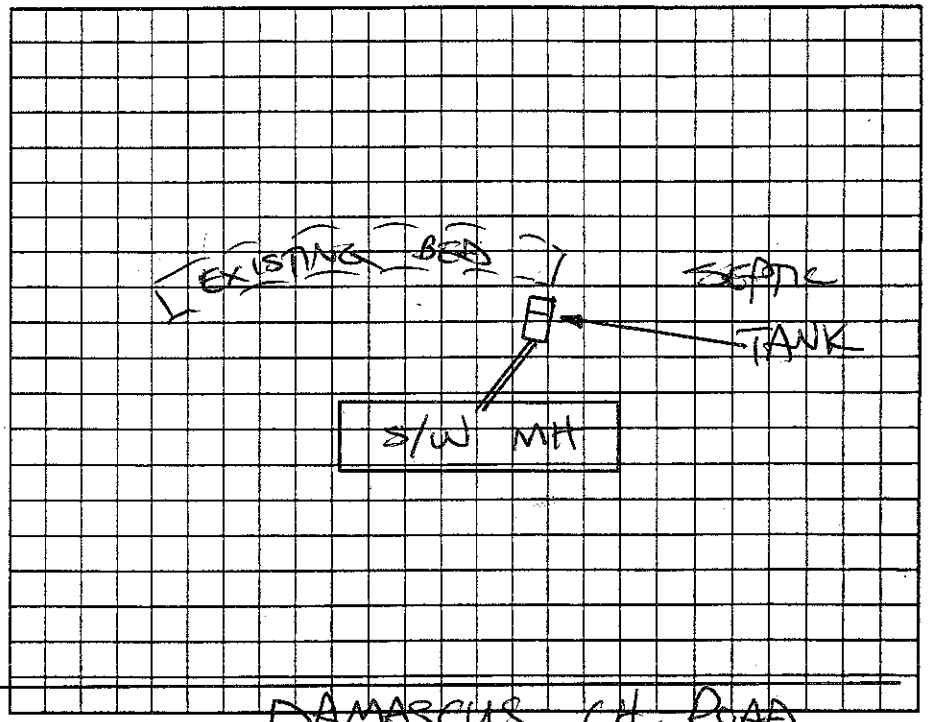

Permit can be suspended or revoked if any false information is supplied toward securing the permit/any unauthorized changes are made to the site/any unauthorized changes are made in the installation of the system. Improvement Permit with plat valid without expiration ☐ Improvement Permit with site plan valid for sixty months ☐ Authorization to Construct is valid for a period equal to that of Improvement Permit – not to exceed sixty months.

Signed: ____ date ____

Improvement Permit by: ____ date ____

Authorization to Construct by: ____ date ____

Installed by: ____

Operation Permit by: ____ date ____

Existing System Inspection by: STEVE HENDRICK date 5-31-06

HEALTH DEPT. COPY: WHITE OWNER COPY (FINAL): YELLOW OWNER COPY (INITIAL): PINK