IREDELL COUNTY HEALTH DEPARTMENT - ENVIRONMENTAL HEALTH ☑ STATESVILLE OFFICE 704-878-5305 ☐ MOORESVILLE OFFICE 704-664-5281

IMPROVEMENT PERMIT / AUTHORIZATION TO CONSTRUCT / OPERATION PERMIT / EXISTING SYSTEM INSPECTION

PERMIT # 166382 PIN # 4810-61-4967 DATE 7 June 2011

OWNER Margaret Nance APPLICANT: First Choice Homes

SITE ADDRESS 162 Damascus Church Rd OWNER / APPLICANT ADDRESS PHONE: Home/Cell # Business # (704) 902-7308

SITE DIRECTIONS 115N TL Damascus Ch. Rd. - 4th House on Rt.

SUBDIVISION BLOCK / SECTION LOT # LOT AREA 1.8ac± DESIGN FLOW 2 BR's/d L.T.A.R. 0-3/FH4

Septic Tank 1000 Gallons: STB 760 Date 4-4-11

Pump Tank Gallons: P T Date

Pump Make Model Serial #

No. Nitrification Fields: 1 No. Lines 2 Linear Feet 200

Trench Width 36" Max. Trench Bottom Depth 36" Gravel Depth N/A

☑ New System ☐ Repair ☐ Expansion System Type I II ⓘ IV V VI

System Description: 25% Reduction

Repair System Description: 25% Reduction

Maintenance Agreement Required ☐ YES ☑ NO

☑ GRAVITY ☐ PRESSURE

☑ Residence No. Bedrooms 2

☐ Business No. Persons

☐ Other No. Employees

☐ Slab ☑ Crawl Space


☐ Basement w/plumbing ☐ Basement w/o plumbing

Water Supply: ☑ Private ☐ Public ☐ Community


Comments / Conditions: Existing mobile home to be removed.

PPC Filed

INITIAL SITE SKETCH

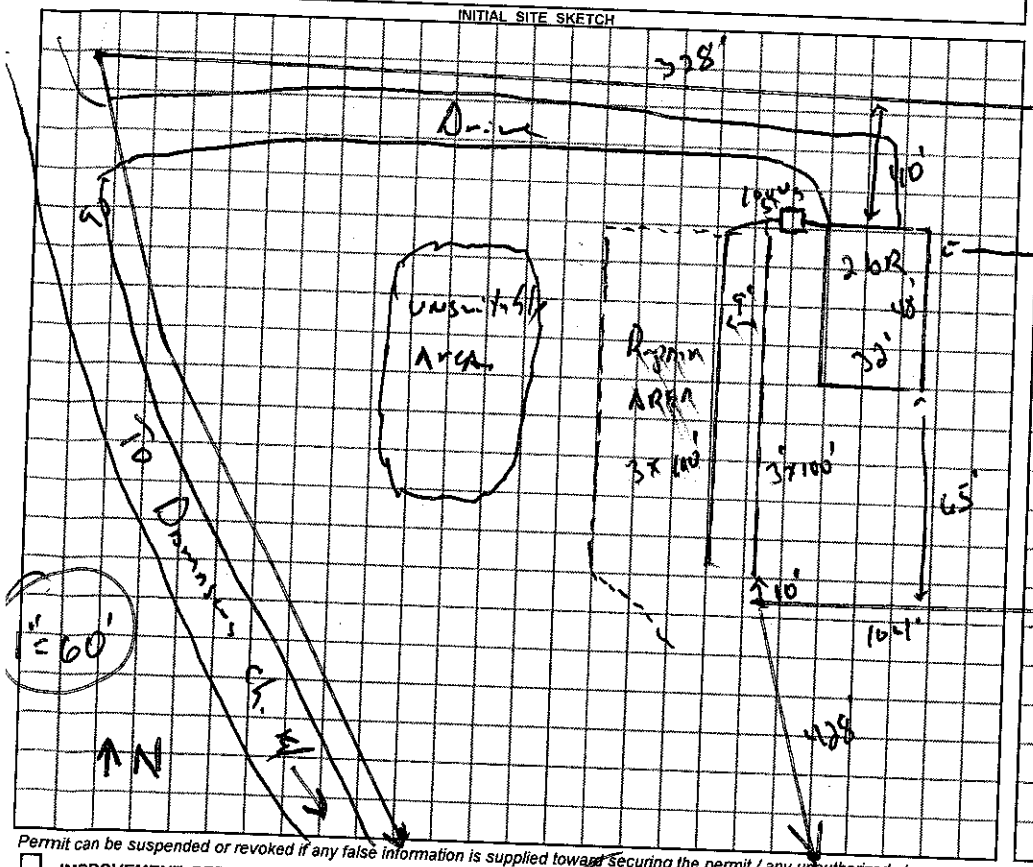

AS BUILT SKETCH

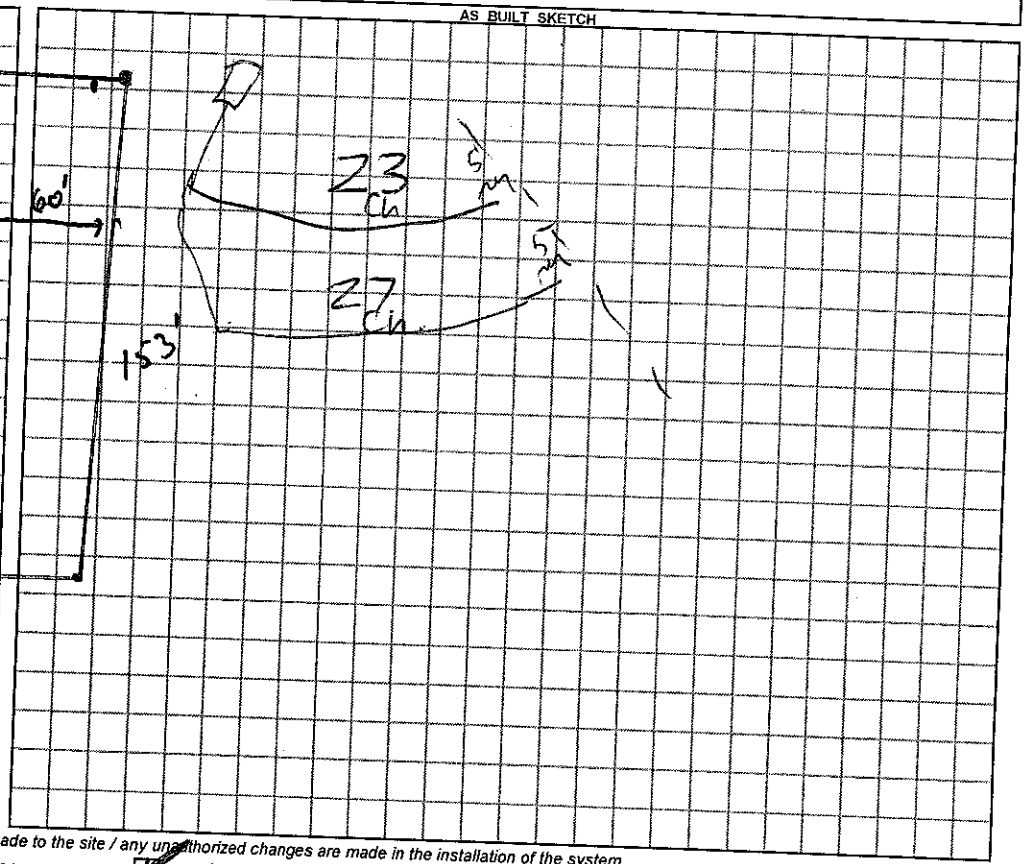

Permit can be suspended or revoked if any false information is supplied toward securing the permit / any unauthorized changes are made to the site / any unauthorized changes are made in the installation of the system.

☐ ***IMPROVEMENT PERMIT*** with plat valid without expiration. ☑ ***IMPROVEMENT PERMIT*** with plat valid without expiration. site plan valid 60 mo. ☑ ***AUTHORIZATION TO CONSTRUCT*** valid for period equal to IMPROVEMENT PERMIT—not to exceed 60 mo.

Owner / Applicant Signature: Date 6-8-11 Installed by: L. Backhoe

IMPROVEMENT PERMIT by: REHS Date 7 June 11 OPERATION PERMIT by: REHS Date 7-20-11

AUTHORIZATION TO CONSTRUCT by: REHS Date 7 June 11 Existing System Inspected by: REHS Date

YOU SHOULD CONTACT A LOCATOR SERVICE PRIOR TO ANY EXCAVATION

White Copy – Environmental Health YELLOW COPY (Final) Owner / Applicant PINK COPY (Initial) Owner / Applicant