IREDELL COUNTY HEALTH DEPARTMENT

STATESVILLE 704-878-5305 MOORESVILLE 704-664-5281

IMPROVEMENT PERMIT / AUTHORIZATION TO CONSTRUCT / OPERATION PERMIT / EXISTING SYSTEM INSPECTION

PERMIT# 125249 PIN# 4810-62-7200 DATE 12-8-04

OWNER OR CONTRACTOR FLEETWOOD HOMES OF STATESVILLE PHONE: Business (704) 872-0179 Home

ADDRESS 1270 NORTHSIDE DR STATESVILLE NC 28677

LOCATION HWY 115N TL HANNAH PROPERTY ON RIGHT IN CURVE

SUBDIVISION MOUNTAINVIEW PARK BLOCK / SECTION LOT 12/13 LOT AREA 1.11 SITE CLASS. PS DESIGN FLOW 480 L.T.A.R. 0.25 gpd/ft²

Septic Tank: 1000 Gallons; STB 1012 Date 6-18-04
Pump Tank: Gallons; PT Date
Pump Make: Model Serial No.
Nitrification Field: No Fields 1 Square Feet 1920 Linear Feet 480'
No Lines 6 Trench Width 36" Max Trench Bottom Depth 36" Gravel Depth N/A

☑ New System ☐ Repair System Type: I, II, (III), IV, V, VI
System Description: GRAVITY, 25% REDUCTION
Repair System Description: LP PANEL 50% REDUCTION
Maintenance Agreement Required: ☐ Yes ☑ No


☑ House/Mod. Home No. Bedrooms 4
☐ Mobile Home No. Bathrooms
☐ Business No. Employees
☐ Other
☐ Slab ☑ Crawl Space ☐ Basement w/plumbing ☐ Basement wo/plumbing

Water Supply: ☑ Individual ☐ Public ☐ Community

Comments/Conditions: ① INSTALL LINES ON CONTOUR ② MAINTAIN ALL SETBACKS ③ KEEP SUBSURFACE WATER DIVERSION AT DEPTH OF 48" AND 5' OFF HOUSE FOUNDATION.


Comments/Conditions: ① YELLOW TUFF-TITE ② SEPTIC TANK W/ RISER 6" ABOVE GRADE ③ INFILTRATOR CHAMBERS ④ TANK SET SIDEWAYS ④ LINES SLIGHTLY STAGGERED ⑤ SUBSURFACE WATER DIVERSION DITCH USED #5 STONE INSTALLED AT 48"

353.0' INITIAL SITE SKETCH (6) DROP BOXES

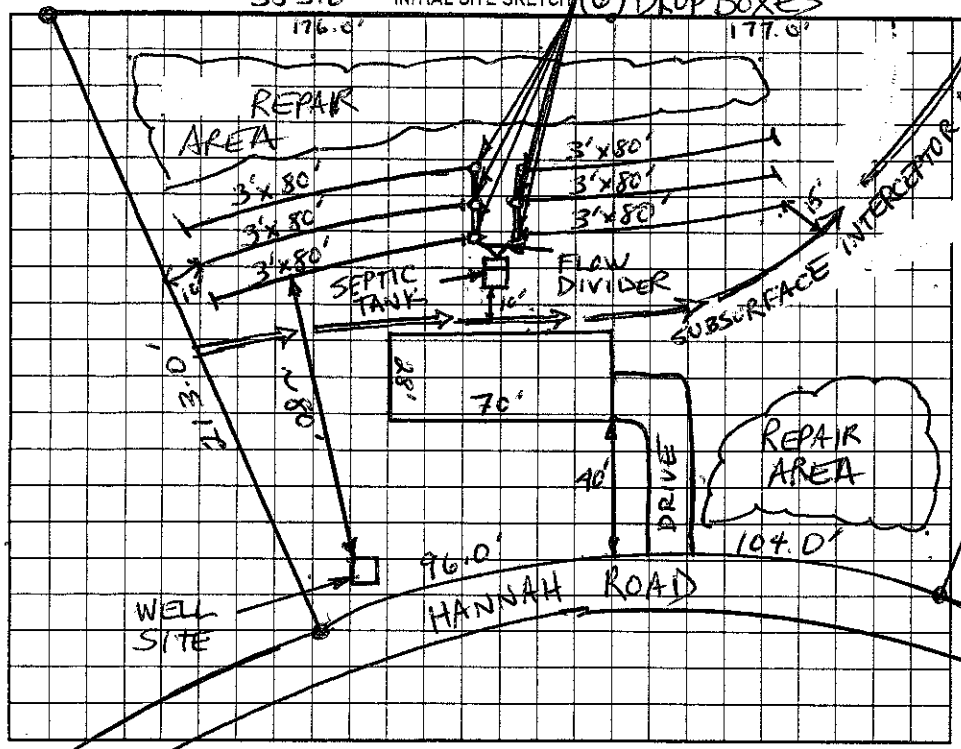

AS BUILT SKETCH

SYSTEM INSTALLED ACCORDING TO AS-BUILT SKETCH

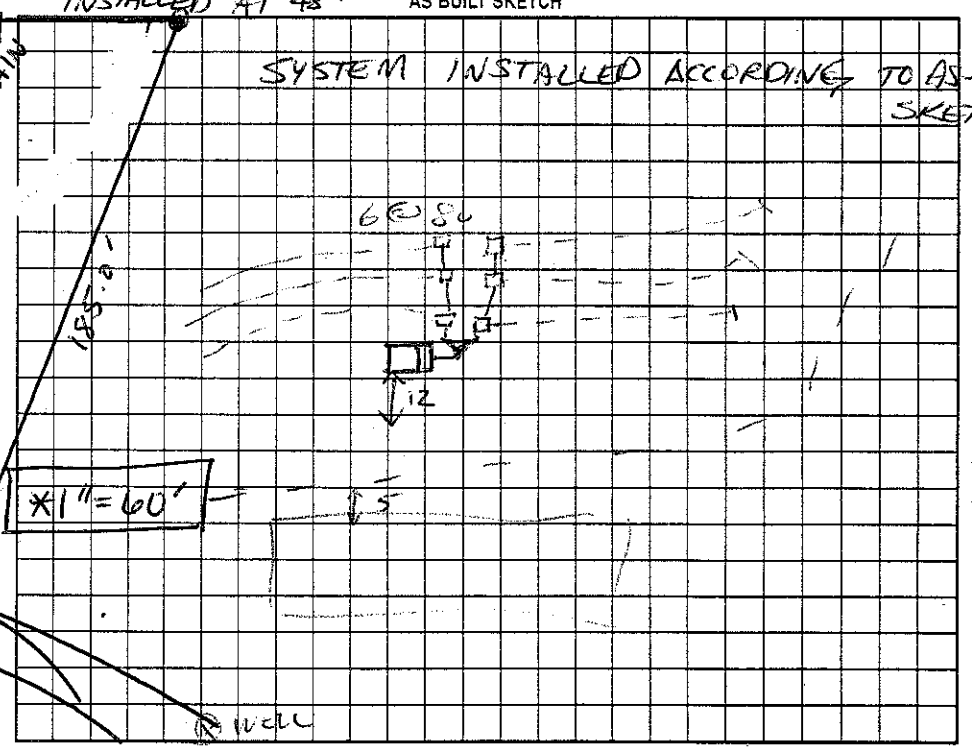

Permit can be suspended or revoked if any false information is supplied toward securing the permit/any unauthorized changes are made to the site/any unauthorized changes are made in the installation of the system. Improvement Permit with plat valid without expiration. Improvement Permit with site plan valid for sixty months. Authorization to Construct is valid for a period equal to that of Improvement Permit – not to exceed sixty months.

Signed: date 12/8/04 Installed by: CRAIG THOMPSON

Improvement Permit by: Christopher M Shell, RS date 12-8-04 Operation Permit by: Christopher M Shell, RS date 12-22-04

Authorization to Construct by: Christopher M Shell, RS date 12-8-04 Existing System Inspection by: date

HEALTH DEPT. COPY: WHITE OWNER COPY (FINAL): YELLOW OWNER COPY (INITIAL): PINK