IREDELL COUNTY HEALTH DEPARTMENT

Statesville Office (704) 878-5305 Mooresville Office (704) 660-3625 PERMIT # 178217

IMPROVEMENT PERMIT / AUTHORIZATION TO CONSTRUCT / OPERATION PERMIT / EXISTING SYSTEM

PIN # 4810701072

APPLICANT: Ronald Looney APPLICANT ADDRESS: 783 Bowles Farm Rd.

SITE ADDRESS: 783 Bowles Farm Rd. PHONE: 704-876-0764 ALT. PHONE: N/A

SITE DIRECTIONS: Hwy 115N TL Bowles Farm Rd. Site on right ~ 1 mile

SUBDIVISION: N/A SECTION: N/A LOT # N/A LOT AREA: 2.7 acres DESIGN FLOW: 360 gpd L.T.A.R.: 6X

Septic Tank 1000 (gal) STB 760 Date 11-13
Pump Tank (gal) PT Date
Pump Make Model Serial #
Nitrification Fields 6X # Lines 6X Linear Ft: 6X
Trench Width 6X Max. Trench Bottom Depth 6X Gravel Depth 6X


☐ New System ☑ Repair ☐ Expansion System Type: I II III IV V VI
System Description:
Repair System Description: TANK
Maintenance Agreement Required: ☐ YES ☑ NO
☑ GRAVITY ☐ PRESSURE

☑ Residence ☐ Business ☐ Other ☐ Slab ☐ Basement w/plumbing
No. Bedrooms 3 No. Persons No. Employees
☑ Crawl Space ☐ Basement w/o plumbing

Water Supply: ☑ Private ☐ Public ☐ Community

Comments / Conditions: - Pump & Crush old septic tank. Install new septic tank at location shown below & connect to existing drainfield.

INITIAL SITE SKETCH

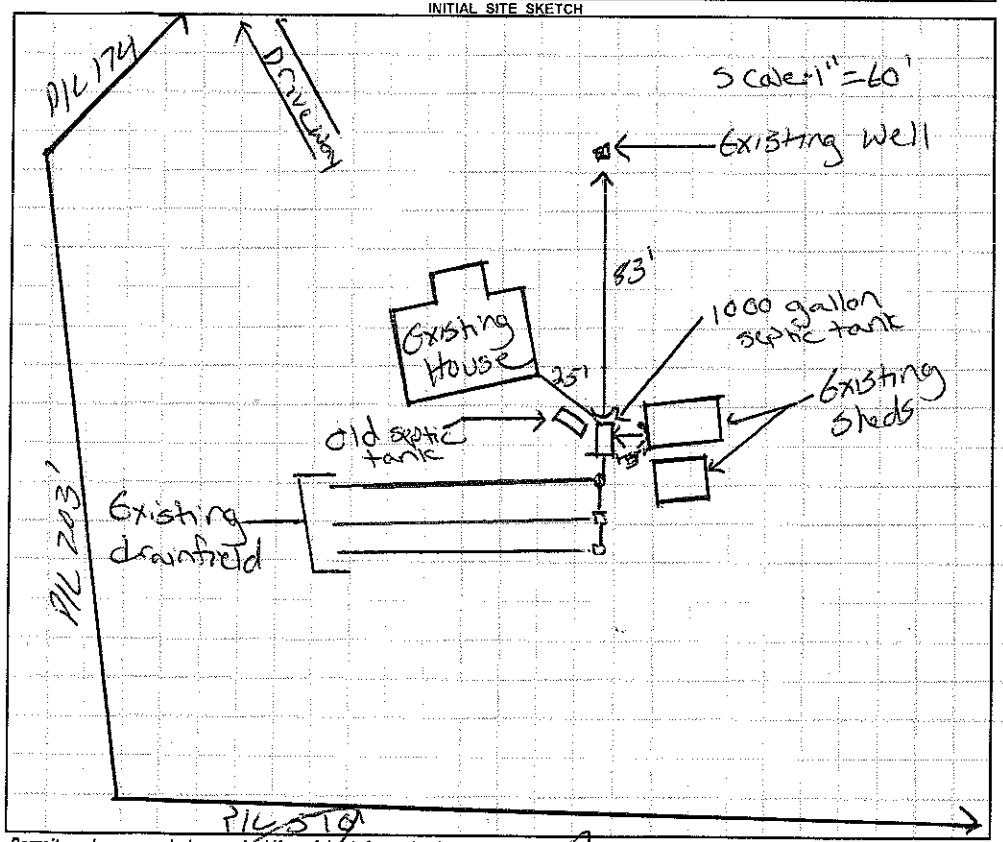

AS BUILT SKETCH

- Red polylok filter installed
- Installed as drawn

Permit can be suspended or revoked if any false information is supplied toward securing the permit / any unauthorized changes are made to the site / any unauthorized changes are made in the installation of the system. **CONTACT A LOCATOR SERVICE PRIOR TO ANY EXCAVATION**

☐ **IMPROVEMENT PERMIT** *with plat* valid without expiration ☐ **IMPROVEMENT PERMIT** *with site plan* valid for 60 mos. ☑ **AUTHORIZATION TO CONSTRUCT** valid for period equal to IMPROVEMENT PERMIT--not to exceed 60 mo.

Owner / Applicant Signature: Ronald Looney Date: Installed by: A1 Backhoe

IMPROVEMENT PERMIT by: Justin Henderson Date: 5-2-13

AUTHORIZATION TO CONSTRUCT by: Justin Henderson Date: 5-2-13

OPERATION PERMIT by: Justin Henderson Date: 5-10-13

Existing System Inspected by: Date:

Health Dept. Copy - WHITE Applicant (Final Approval) - YELLOW Applicant (Conditional Approval) - PINK