IREDELL COUNTY HEALTH DEPARTMENT

STATESVILLE 704-878-5305 (C) MOORESVILLE 704-664-5281

IMPROVEMENT PERMIT / AUTHORIZATION TO CONSTRUCT / OPERATION PERMIT / EXISTING SYSTEM INSPECTION

(E)

PERMIT# 141061 PIN# PART of 4810-70-~~6101~~ 6014 DATE 4-17-07

OWNER OR APPLICANT DEAN GOODIN PHONE: Business Home 704-876-0115

ADDRESS 781 BOWLES FARM ROAD, STATESVILLE, NC 28625

LOCATION NC 115 NORTH, TL BOWLES FARM ROAD ON RIGHT AT #781, 200' + BACK OFF ROAD

SUBDIVISION BLOCK / SECTION LOT LOT AREA 0.806 ACRE SITE CLASS. PS DESIGN FLOW 360 L.T.A.R. 0.30 GPD/FT²

Septic Tank: 1000 Gallons; STB 760 Date 8-7-06
Pump Tank: Gallons; PT Date
Pump Make: Model Serial No.
Nitrification Field: No Fields 1 Square Feet 600 TO 1200 Linear Feet 300
No Lines FOUR Trench Width 36" Max Trench Bottom Depth 36" Gravel Depth N/A

☑ New System ☐ Repair ☐ Expansion System Type: I II III IV V VI
System Description: 25% REDUCTION, GRAVITY
Repair System Description: 25% REDUCTION, GRAVITY
Maintenance Agreement Required: ☐ Yes ☑ No

☐ House/Mod. Home ☑ Mobile Home ☐ Business ☐ Other
No. Bedrooms 3 No. Persons No. Employees


Water Supply: ☑ Individual ☐ Public ☐ Community WELL NEXT DOOR

☑ Gravity ☐ Pressure ☐ Slab ☑ Crawl Space ☐ Basement w/plumbing ☐ Basement wo/plumbing


Comments:/Conditions: INSTALL 25% REDUCTION SYSTEM ON CONTOUR AS FLAGGED ON SITE

Comments:/Conditions: SEPTIC TANK WITH RISERS INSTALLED USING RED "POLYLOK" FILTER

INITIAL SITE SKETCH

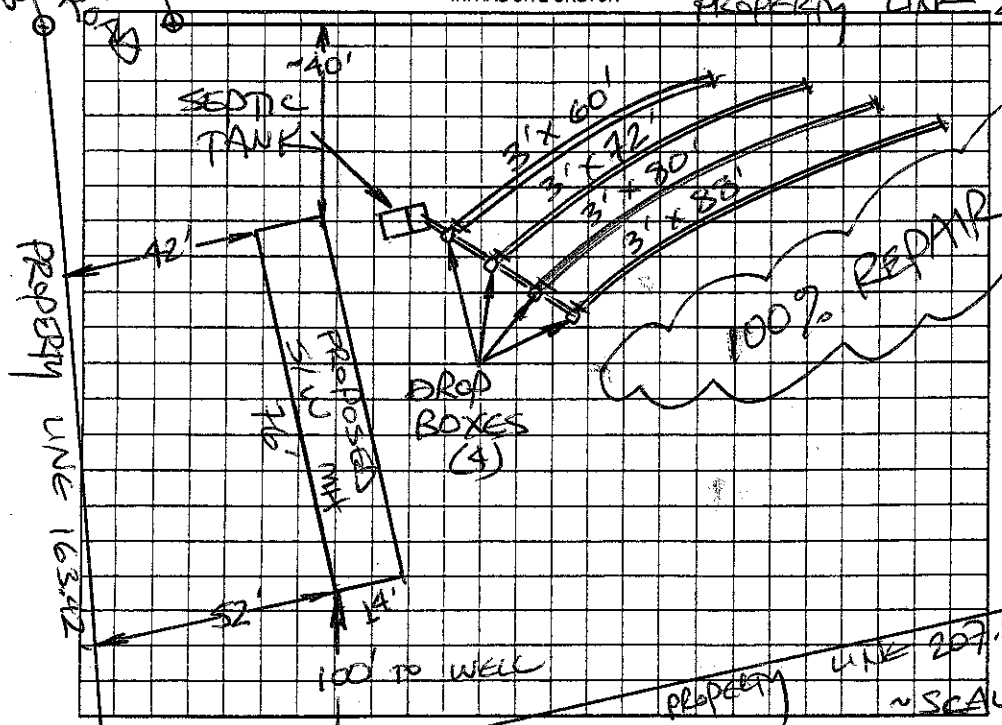

AS BUILT SKETCH

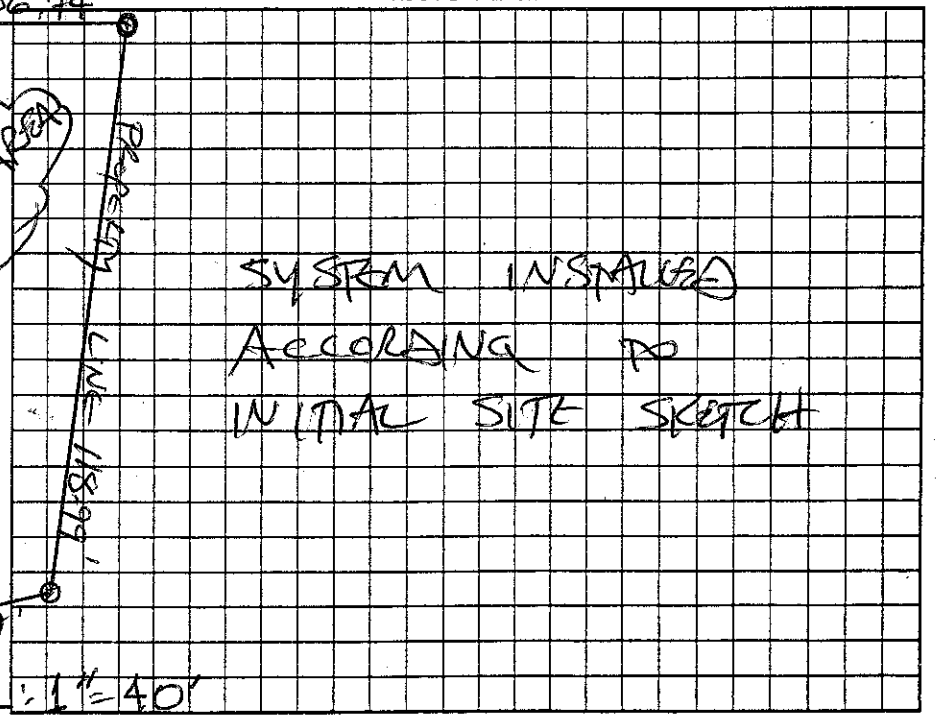

Permit can be suspended or revoked if any false information is supplied toward securing the permit/any unauthorized changes are made to the site/any unauthorized changes are made in the installation of the system. Improvement Permit with plat valid without expiration ☐ Improvement Permit with site plan valid for sixty months ☑ Authorization to Construct is valid for a period equal to that of Improvement Permit – not to exceed sixty months.

Signed: Cathy Goodin date 4-17-07 Installed by: BRENT GALLIHER

Improvement Permit by: STEVE HEDRICK date 4-17-07 Operation Permit by: STEVE HEDRICK date 5-4-07

Authorization to Construct by: STEVE HEDRICK date 4-17-07 Existing System Inspection by: date

HEALTH DEPT. COPY: WHITE OWNER COPY (FINAL): YELLOW OWNER COPY (INITIAL): PINK