IREDELL COUNTY HEALTH DEPARTMENT

STATESVILLE 704-878-5305 (C1) MOORESVILLE 704-664-5281

IMPROVEMENT PERMIT / AUTHORIZATION TO CONSTRUCT / OPERATION PERMIT / EXISTING SYSTEM INSPECTION

(C) PERMIT# 106464 PIN# 4810-71-3876 DATE 6-3-02

OWNER OR CONTRACTOR JONNIE CLANTON PHONE Business Home 704-876-6946

ADDRESS 602 BELLE MEADE AVE STATESVILLE NC 28677

LOCATION NC 115 N TL DAMASCUS CH. ROAD, 3RD LOT ON RIGHT

SUBDIVISION BLOCK / SECTION LOT LOT AREA 200' x 250' SITE CLASS PS DESIGN FLOW 360 L.T.A.R. 0.30 GPD/FT2

Septic Tank: 1000 Gallons: STB 1012 Date 2-11-02
Pump Tank: Gallons: PT Date
Pump Make: Model Serial No
Nitrification Field: No Fields 1 Square Feet 1200 Linear Feet 400
No Lines FOUR Trench Width 36" Max Trench Bottom Depth 36" Gravel Depth 12"

☑ New System ☐ Repair System Type: (I) II III IV V VI
System Description: CONVENTIONAL GRAVITY
Repair System Description: CONVENTIONAL GRAVITY
Maintenance Agreement Required: ☐ Yes ☑ No


☑ House/Mod Home No Bedrooms 3
☐ Mobile Home No. Bathrooms 2
☐ Business No Employees
☐ Other
☐ Slab ☑ Crawl Space ☐ Basement w/plumbing ☐ Basement wo/plumbing

Water Supply: ☐ Individual ☑ Public ☐ Community

Comments/Conditions:

Comments/Conditions: SEPTIC TANK WITH MARKER INSTALLED USING "FAYLOR" FILTER

INITIAL SITE SKETCH

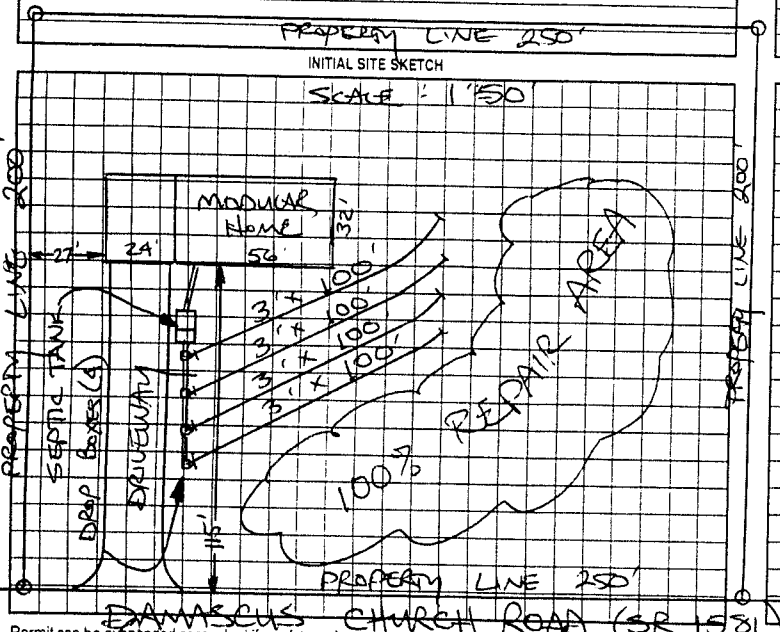

AS BUILT SKETCH

SYSTEM INSTALLED ACCORDING TO INITAL SITE SKETCH

Permit can be suspended or revoked if any false information is supplied toward securing the permit/any unauthorized changes are made to the site any unauthorized changes are made in the installation of the system. Improvement Permit with plat valid without expiration. Improvement Permit with site plan valid for sixty months. Authorization to Construct is valid for a period equal to that of Improvement Permit – not to exceed sixty months

Signed: [signature] date 6/3/02 Installed by TOMMY FRYE

Improvement Permit by: STEVE HEDRICK date 6-3-02 Operation Permit by STEVE HEDRICK date 7-10-02

Authorization to Construct by: STEVE HEDRICK date 6-3-02 Existing System Inspection by: date

HEALTH DEPT COPY WHITE OWNER COPY (FINAL) YELLOW OWNER COPY (INITIAL) PINK