IREDELL COUNTY HEALTH DEPARTMENT

STATESVILLE 704-878-5305 MOORESVILLE 704-664-5281

IMPROVEMENT PERMIT / AUTHORIZATION TO CONSTRUCT / OPERATION PERMIT / EXISTING SYSTEM INSPECTION

PERMIT# 074693 PIN# 4810 72 1295 DATE 7-20-98

OWNER OR CONTRACTOR MICHAEL N. SLOAN PHONE: Business Home 876-2881

ADDRESS 329 MOUNTAIN VIEW ROAD STATESVILLE, NC 28625

LOCATION NC 115 N, TL HANNAH ROAD, TL 1ST DRIVE, 2ND HOUSE ON RIGHT

SUBDIVISION MTN. VIEW PARK BLOCK / SECTION LOT 30 LOT AREA ~120'X175' SITE CLASS. P5 DESIGN FLOW 360 L.T.A.R. 0.30 SPO/FT²

Septic Tank: 1000 Gallons; STB 525 Date 6-16-98

Pump Tank: Gallons; PT Date

Pump Make: Model Serial No.

Nitrification Field: No Fields 1 Square Feet 1200 Linear Feet 400

No Lines FIVE Trench Width 36" Max Trench Bottom Depth 36" Gravel Depth 12"

☑ New System ☐ Repair System Type: I, II, III, IV, V, VI

System Description: CONVENTIONAL GRAVITY

Repair System Description: CONV. GRAVITY

Maintenance Agreement Required: ☐ Yes ☑ No

☑ House/Mod. Home No. Bedrooms 3

☐ Mobile Home No. Bathrooms 2

☐ Business No. Employees

☐ Other


☐ Slab ☑ Crawl Space ☐ Basement w/plumbing ☐ Basement wo/plumbing

Water Supply: ☑ Individual ☐ Public ☐ Community WELL

Comments:/Conditions: KEEP SYSTEM MAXIMUM FEASIBE DISTANCE (65') FROM WELL

Comments:/Conditions: Inspected S.T. & 4 upper Drain lines

~SCALE: 1"=40' INITIAL SITE SKETCH

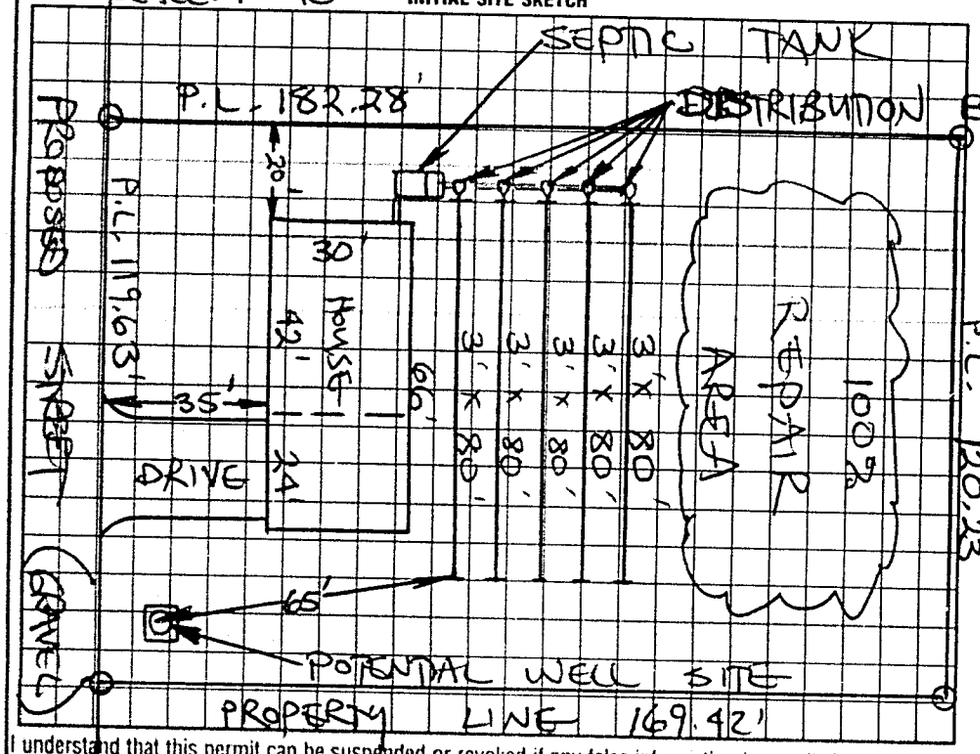

AS BUILT SKETCH

Installed as shown

I understand that this permit can be suspended or revoked if any false information is supplied toward securing the permit/any unauthorized changes are made to the site/any unauthorized changes are made in the installation of the system. Improvement Permit with plat valid without expiration. Improvement Permit with site plan valid for sixty months. Authorization to Construct is valid for a period equal to that of Improvement Permit – not to exceed sixty months.

Signed: X Michael Sloan

Improvement Permit by: STEVE HEDRICK date 7-20-98

Authorization to Construct by: STEVE HEDRICK date 7-20 98

Installed by: C+W Grading + Septic

Operation Permit by: [illegible] date 7-29-98

Existing System Inspection by date

HEALTH DEPT. COPY: WHITE INSPECTION COPY (FINAL): GREEN OWNER COPY (FINAL): YELLOW INSPECTION COPY (INITIAL): PINK OWNER COPY (INITIAL): GOLD