IREDELL COUNTY HEALTH DEPARTMENT

Statesville Phone TR 3-7271 Mooresville Phone NO 3-1271

PERMIT TO INSTALL SEPTIC TANK

Permit NO. 239 Permit Date July 21 1970

Owner Hope Beds. Builders Address Statesville, N.C.

Installed By Adams Septic Tank Service Address Taylorsville, N.C.


Location of Property Highway 115 North - Past Central School to Mt. View Park. Turn Left 2nd house on Right

Tank		Capacity		Length of Lines		Fixtures	
Block	( )	1000	(✓)	225'	(✓)	No. of Baths	(✓)
Precast	(✓)	1250	( )	250'	( )	Dishwasher	( )
		1500	( )	Other		Garbage Grdr.	( )
		Other				Other	

NOTIFY HEALTH DEPARTMENT AT LEAST EIGHT HOURS BEFORE TANK IS TO BE INSPECTED.

Final Inspection July 21 1970 Approved (✓) Disapproved ( )

Remarks

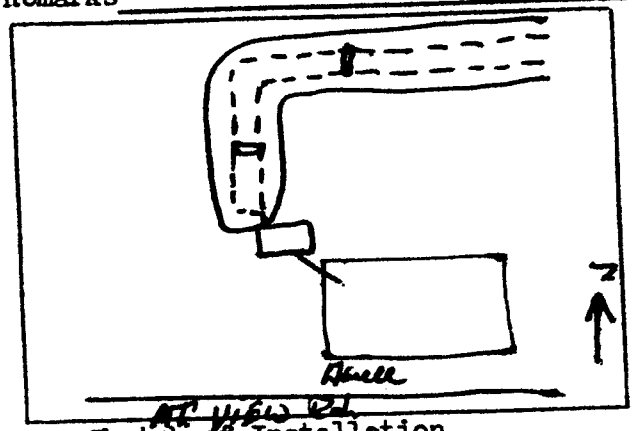

Sketch of Installation

Sanitarian