IREDELL COUNTY HEALTH DEPARTMENT

STATESVILLE 704-878-5305 MOORESVILLE 704-664-5281

IMPROVEMENT PERMIT / AUTHORIZATION TO CONSTRUCT / OPERATION PERMIT / EXISTING SYSTEM INSPECTION

PERMIT# 086612 PIN# 4810 74 8200 DATE 12-22-99

OWNER OR CONTRACTOR RANDY SMITH PHONE: Business 876-2881 (MIKE SLOAN) Home

ADDRESS 240 HARTNESS ROAD, STATESVILLE, NC 28677

LOCATION NC 115 N, TL ERNEST ROAD, LOT ON RIGHT INSIDE CURVE

SUBDIVISION BLOCK / SECTION LOT LOT AREA 0.9479 ACRE SITE CLASS PS DESIGN FLOW 360 L.T.A.R. 0.40 gpd/ft²

Septic Tank: 1000 Gallons; STB 825 Date 12-5-99
Pump Tank: Gallons; PT Date
Pump Make: Model Serial No.
Nitrification Field: No Fields 1 Square Feet 900 Linear Feet 300
No Lines FOUR Trench Width 36" Max Trench Bottom Depth 36" Gravel Depth 12"

☑ New System ☐ Repair System Type: I (II) III. IV. V. VI
System Description: CONVENTIONAL GRAVITY
Repair System Description: CONV. GRAVITY
Maintenance Agreement Required: ☐ Yes ☑ No

☑ House/Mod. Home No. Bedrooms 3
☐ Mobile Home No. Bathrooms 2½
☐ Business No. Employees
☐ Other


☐ Slab ☑ Crawl Space ☐ Basement w/plumbing ☐ Basement wo/plumbing

Water Supply: ☑ Individual ☐ Public ☐ Community
WELL

Comments:/Conditions: KEEP SYSTEM MINIMUM 100 FEET FROM WELL

Comments:/Conditions: SEPTIC TANK WITH RISERS INSTALLED USING "POLYLOK" FILTER

INITIAL SITE SKETCH

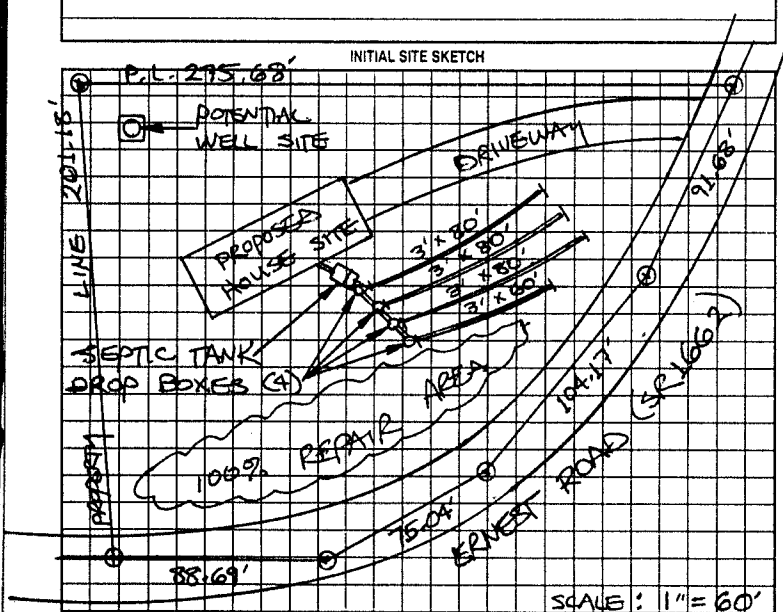

AS BUILT SKETCH

SYSTEM INSTALLED ACCORDING TO INITAL SITE SKETCH

Permit can be suspended or revoked if any false information is supplied toward securing the permit/any unauthorized changes are made to the site/any unauthorized changes are made in the installation of the system. Improvement Permit with plat valid without expiration. Improvement Permit with site plan valid for sixty months. Authorization to Construct is valid for a period equal to that of Improvement Permit – not to exceed sixty months.

Signed: Michael Sloan date 12-30-99 Installed by: C & W GRADING

Improvement Permit by: STEVE HEDRICK date 12-22-99 Operation Permit by: STEVE HEDRICK date 2-16-00

Authorization to Construct by: STEVE HEDRICK date 12-22-99 Existing System Inspection by: date

HEALTH DEPT. COPY: WHITE OWNER COPY (FINAL): YELLOW OWNER COPY (INITIAL): PINK