55102 THIS PERMIT VOIDS PREVIOUS ISSUED 4/5/94

IREDELL COUNTY HEALTH DEPARTMENT

STATESVILLE 704-878-5305 MOORESVILLE 704-664-5281

IMPROVEMENT PERMIT / CERTIFICATE OF COMPLETION / OPERATION PERMIT / EXISTING SYSTEM INSPECTION

PROPERTY DESCRIPTION NO. 18137 / 20624 DATE 4/18/95 TAX MAP NO. 14J - A - 24 Watershed: ☐ Yes ☒ No

OWNER OR CONTRACTOR MICHAEL N. GOODE PHONE: Business Home 838-1110

ADDRESS 608 C-5 FOXCROFT TERRACE, STATESVILLE, NC 28677

LOCATION NE115 N, TL MTN. VIEW RD, TL NEWLANDS LANE, HOUSE ON (R) ~ 800'

SUBDIVISION BLOCK / SECTION LOT LOT AREA 1.4 AC SITE CLASS. PS DESIGN FLOW 460 L.T.A.R. 0.35 GPD/FT²

Septic Tank: 1000 Gallons; STB 794 Date 2/25/95
Pump Tank: Gallons; PT Date
Pump Make: Model Serial No.
Nitrification Field: No Fields 1 Square Feet 320 Linear Feet 440
No Lines 4 Trench Width 36" Max Trench Bottom Depth 18-36 Gravel Depth 12"

☑ New System ☐ Repair System Type: I, II, III, IV, V, VI
System Description: CONVENTIONAL GRAVITY
Repair System Description: CONV. GRAVITY
Maintenance Agreement Required: ☐ Yes ☒ No

☑ House/Mod. Home No. Bedrooms
☐ Mobile Home No. Bathrooms
☐ Business No. Employees
☐ Other


☐ Slab ☒ Crawl Space ☐ Basement w/plumbing ☐ Basement wo/plumbing

Water Supply: ☒ Individual ☐ Community ☐ Public WELL

Comments: ① KEEP SYSTEM MINIMUM 100' FROM WELL ② INSTALL LINES AS SHOWN NO DEEPER THAN 36", ON CONTOUR.

Comments:

INITIAL SITE SKETCH

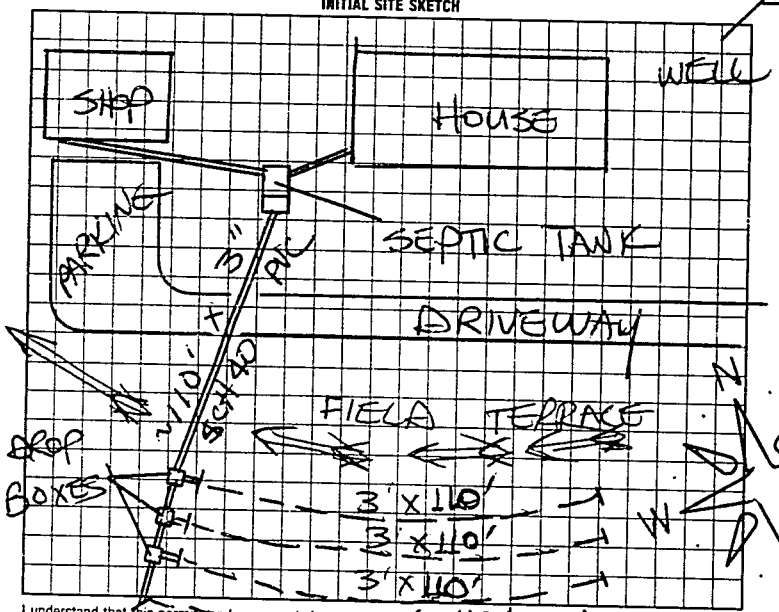

AS BUILT SKETCH

SYSTEM INSTALLED ACCORDING TO INITIAL SITE SKETCH

— BACK OFF ROAD ~ 700'

I understand that this permit can be suspended or revoked if any false information is supplied toward securing the permit/any unauthorized changes are made to the site/any unauthorized changes are made in the installation of the system. Improvement Permit is valid for 60 months from date of issuance.

Signed: X Edward Shumaker

Improvement Permit by: STEVE HEDRICK date 4/18/95

Existing System Inspection by: date

Installed by: JAMES HULER

Certificate of Completion by: STEVE HEDRICK date 4/25/95

Operation Permit by: date

HEALTH DEPT. COPY: WHITE INSPECTION COPY (FINAL): GREEN OWNER COPY (FINAL): YELLOW INSPECTION COPY (INITIAL): PINK OWNER COPY (INITIAL): GOLD