IREDELL COUNTY HEALTH DEPARTMENT

Statesville Phone TR 3-7271 Mooresville Phone NO 3-1271

PERMIT TO INSTALL SEPTIC TANK

Permit No. 173 Permit Date 7-11 19 72

Owner Forrest Goodin Address

Installed By Herman Gibson Address Statesville N.C.

Location of Property Out 115 Above Central School T.L. on Road # 1583 - Go about 1000 ft T.L. in Driveway


Tank		Capacity		Length of Lines		Fixtures	
Block	( )	1000	(✓)	225'	(✓)	No. of Baths	(1½)
Precast	(✓)	1250	( )	250'	( )	Dishwasher	( )
		1500	( )	Other		Garbage Grdr.	( )
		Other				Other	

NOTIFY HEALTH DEPARTMENT AT LEAST EIGHT HOURS BEFORE TANK IS TO BE INSPECTED.

Final Inspection 7-11 19 72 Approved (✓) Disapproved ( )

Remarks

45x50 Barn

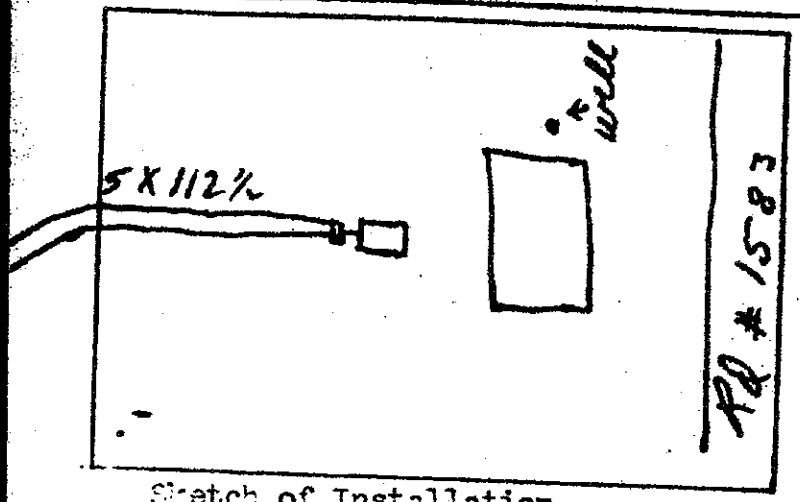

Sketch of Installation

Location of the proposed 45'x50' Pole barn addition does not appear to impact the existing on-site septic system.**NOTE:

REHS

Date: 4-12-12

ICHD-Environmental Health Division

E. G. Stevenson

Sanitarian