IREDELL COUNTY HEALTH DEPARTMENT

Statesville Office (704) 878-5305 Mooresville Office (704) 660-3625 PERMIT # 180812

IMPROVEMENT PERMIT / AUTHORIZATION TO CONSTRUCT / OPERATION PERMIT / EXISTING SYSTEM

PIN # 4810777844

APPLICANT: Justine Beltz APPLICANT ADDRESS: 326 Nursery Lane Statesville, NC 28677

SITE ADDRESS: 306 Mountain View Rd Statesville, NC PHONE: 704 / 253 5164 ALT. PHONE:

SITE DIRECTIONS: 115N ~ 10 miles, (L) Mountain View Rd; site is on (R)

SUBDIVISION: n/a SECTION: n/a LOT # n/a LOT AREA: 13.85 Acres DESIGN FLOW: 600 L.T.A.R.: .3

Septic Tank	1500 (gal)	STB	1500-52	Date	NO DATE	[X] New System	[ ] Repair	[ ] Expansion	System Type: I II (III) IV V VI	[X] Residence	No. Bedrooms 5	Water Supply
Pump Tank	(gal)	PT		Date		System Description:	25% Reduction Gravity			[ ] Business	No. Persons	[X] Private
Pump Make		Model		Serial #		Repair System Description:	25% Reduction Gravity			[ ] Other	No. Employees	[ ] Public
# Nitrification Fields	1	# Lines	4	Linear Ft:	500	Maintenance Agreement Required:	[ ] YES	[X] NO		[ ] Slab	[X] Crawl Space	[ ] Community
Trench Width	36"	Max. Trench Bottom Depth	36"	Gravel Depth	n/a		[X] GRAVITY	[ ] PRESSURE		[ ] Basement w/plumbing	[ ] Basement w/o plumbing	

Comments / Conditions:


INITIAL SITE SKETCH

- No DATE ON TANK! Will wait 30 days to sign OP (2-27-14)
- Red Polylok filter installed
- septic tank w/risers installed
- supply line from septic tank to distribution box installed +30" deep

Installed as drawn

AS BUILT SKETCH

See attached Design & Specifications by Larry Thompson LSS

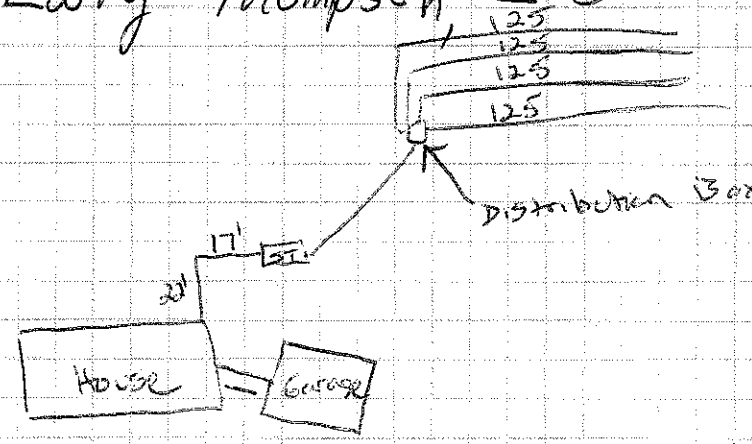

Permit can be suspended or revoked if any false information is supplied toward securing the permit / any unauthorized changes are made to the site / any unauthorized changes are made in the installation of the system. **CONTACT A LOCATOR SERVICE PRIOR TO ANY EXCAVATION**

[ ] **IMPROVEMENT PERMIT** *with plat valid without expiration.* [X] **IMPROVEMENT PERMIT** *with site plan valid for 60 mos.* [X] **AUTHORIZATION TO CONSTRUCT** *valid for period equal to IMPROVEMENT PERMIT--not to exceed 60 mo.*

Owner / Applicant Signature: Date: 9-20-13 Installed by: Tim Summey

IMPROVEMENT PERMIT by: Date: 9-16-13 OPERATION PERMIT by: Date: 3-28-14

AUTHORIZATION TO CONSTRUCT by: Date: 9-14-13 Existing System Inspected by: Date:

Health Dept. Copy - WHITE Applicant (Final Approval) - YELLOW Applicant (Conditional Approval) - PINK