DOLLAR GENERAL

Lots 22-Pt. 29

IREDELL COUNTY HEALTH DEPARTMENT

Statesville Office (704) 878-5305 Mooresville Office (704) 660-3625 PERMIT # 218210

IMPROVEMENT PERMIT / AUTHORIZATION TO CONSTRUCT / OPERATION PERMIT / EXISTING SYSTEM

PIN # 4810-81-1948

APPLICANT: Venture Properties VII LLC APPLICANT ADDRESS: PO Box 843 Wilkesboro NC 28697

SITE ADDRESS: 4276 Wilkesboro Hwy Statesville NC 28625 PHONE: 336-667-8000 ALT. PHONE: 704-873-3001


SITE DIRECTIONS: Hwy 115 N, Site on R Before Cove Valley Sign.

SUBDIVISION: Mrs. Elizabeth Sloan Burke Prop. SECTION: — LOT # 3-4 LOT AREA: 1.566 DESIGN FLOW: 200 GPD L.T.A.R.: .275 I / .25 R


Septic Tank	1000 (gal)	STB	Date	☒ New System ☐ Repair ☐ Expansion	System Type: I II ☒ III IV V VI	☐ Residence	No. Bedrooms		Water Supply
Pump Tank	1000 (gal)	PT	Date	System Description: 25% Reduction - Pump		☒ Business	No. Persons		☐ Private
Pump Make		Model	Serial #	Repair System Description: LP-PBPS		☐ Other	No. Employees	6	☒ Public
# Nitrification Fields	1	# Lines	4	Linear Ft: 182'	Maintenance Agreement Required: ☐ YES ☒ NO	☒ Slab	☐ Crawl Space		☐ Community
Trench Width	36"	Max. Trench Bottom Depth	*24"-36"*	Gravel Depth N/A	☒ GRAVITY ☐ PRESSURE	☐ Basement w/plumbing		☐ Basement w/o plumbing	

Comments / Conditions: Combine Top 2 Lines To Make 61' Total. Use 3 1/2" Sch. 80 Taps For Equal Length Lines. (3 x 61'). Follow All Rules For NCDENR Memorandum For Design Flow Reduction For Dollar General Stores To Be Eligible For 200 GPD Usage. *On (20'+40') 61' Line Feed 40' First Then Drop To 20' Line.

INITIAL SITE SKETCH

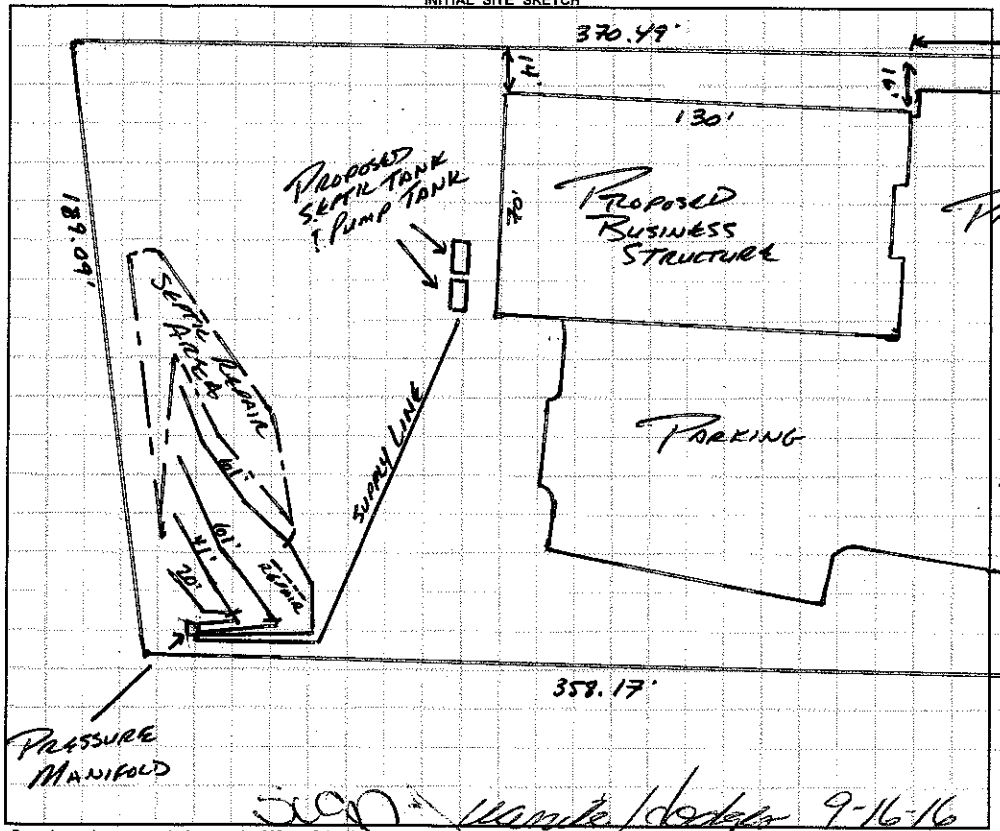

AS BUILT SKETCH

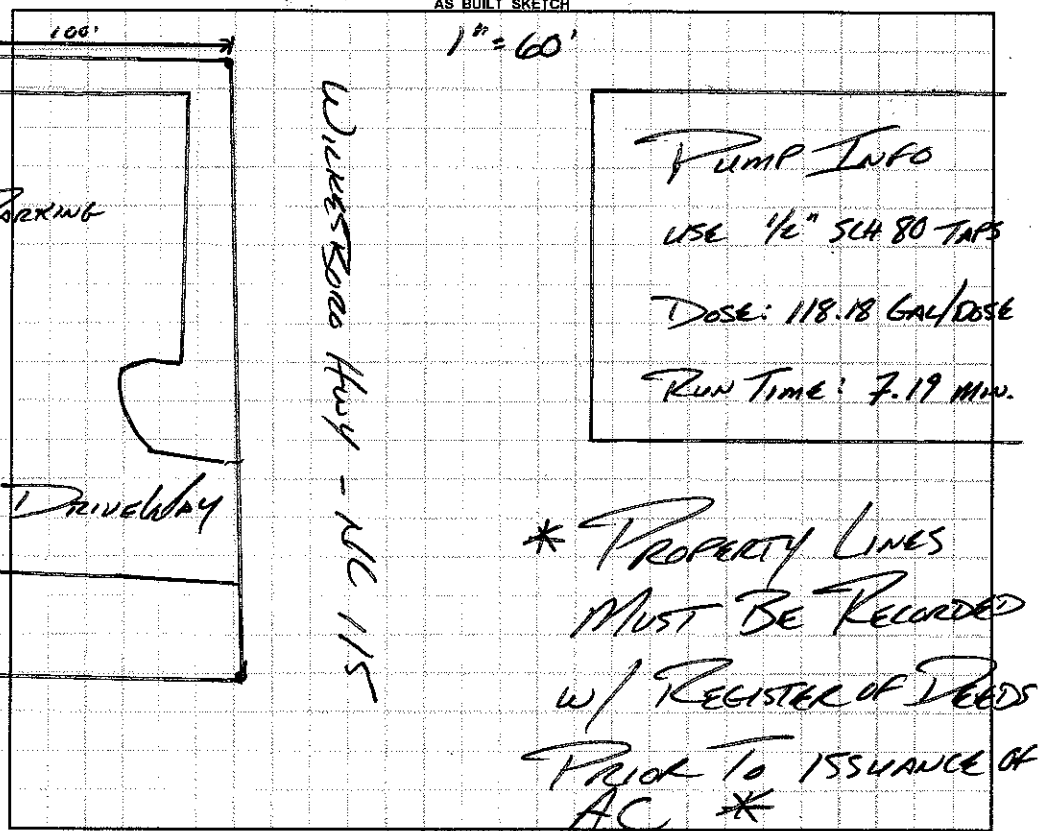

JCD - Unable to locate 9-16-16

Permit can be suspended or revoked if any false information is supplied toward securing the permit / any unauthorized changes are made to the site / any unauthorized changes are made in the installation of the system. **CONTACT A LOCATOR SERVICE PRIOR TO ANY EXCAVATION**

☐ **IMPROVEMENT PERMIT** *with plat valid without expiration.* ☒ **IMPROVEMENT PERMIT** *with site plan valid for 60 mos.* ☒ **AUTHORIZATION TO CONSTRUCT** *valid for period equal to IMPROVEMENT PERMIT--not to exceed 60 mo.*

Owner / Applicant Signature: Savanna B. Date: 6-23-16 Installed by: VEJ

IMPROVEMENT PERMIT by: APPROVED JUN 15 2016 Date: OPERATION PERMIT by: Date: 12-15-16

AUTHORIZATION TO CONSTRUCT by: Date: 09/15/16 Existing System Inspected by: Date:

Health Dept. Copy - WHITE Applicant (Final Approval) - YELLOW Applicant (Conditional Approval) - PINK