42911

IREDELL COUNTY HEALTH DEPARTMENT

STATESVILLE 704-878-5305 MOORESVILLE 704-664-5281

IMPROVEMENT PERMIT / CERTIFICATE OF COMPLETION / OPERATION PERMIT / EXISTING SYSTEM INSPECTION

DATE 6/24/93 TAX MAP NO. 145-2-A-7

PROPERTY DESCRIPTION NO. 16548 PHONE: Business Home 876-1708

OWNER OR CONTRACTOR MATTHEW S. WILLIAMS

ADDRESS RT 11 Box 212 STATESVILLE, NC 28677

LOCATION NC 115 N, 1 MI (R) JUST PAST DAMASCUS CHURCH ROAD

SUBDIVISION BLOCK / SECTION LOT LOT AREA 100'x300' SITE CLASS. PS L.T.A.R. 0.40 GPD/FT²

Water Supply: ☑ Individual ☐ Community ☐ Public WELL NEXT DOOR

Septic Tank: 1000 Gallons; STB 10/2 Date 4/28/93

Pump Tank: Gallons; PT Date

Nitrification Field: No Fields 1 Square Feet 900 Linear Feet 300

No Lines 3 Trench Width 30" Trench Depth 30" Gravel Depth 12"

☑ New System ☐ Repair System Type: I, II, III, IV, V, VI

System Description: CONV. GRAVITY

Repair System Description: CONV. GRAVITY

Maintenance Agreement Required: ☐ Yes ☑ No

☐ House/Mod. Home ☑ Mobile Home ☐ Business ☐ Other PLANNED FOR 3BR

No. Bedrooms 3 No. Bathrooms 2 No. Employees

Garbage Disposal: ☐ Yes ☑ No

Auto. Dishwasher: ☑ Yes ☐ No


Auto. Washing Machine: ☑ Yes ☐ No

Other

☐ Slab ☑ Crawl Space ☐ Basement w/plumbing ☐ Basement wo/plumbing

Comments (1) KEEP SYSTEM MINIMUM 5' FROM MH, 10' FROM PROPERTY LINE ON CONTOUR, 100' FROM NEIGHBORING WELL (2) INSTALL LINES NO DEEPER THAN 30", 9' ON CENTER.

INITIAL SITE SKETCH

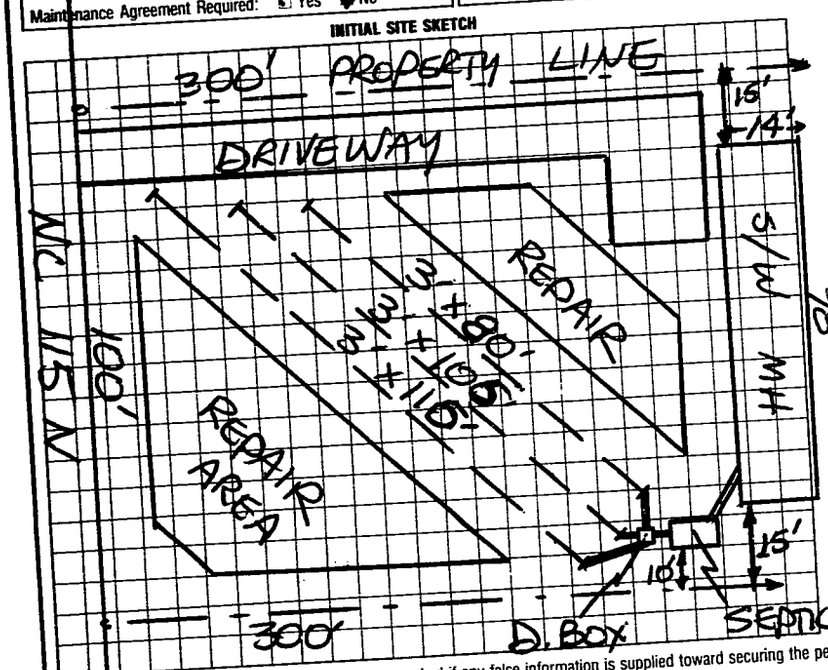

AS BUILT SKETCH

INSTALLED ACCORDING TO INITIAL SITE SKETCH

I understand that this permit can be suspended or revoked if any false information is supplied toward securing the permit/any unauthorized changes are made to the site/any unauthorized changes are made in the installation of the system. Improvement Permit is valid for 60 months from date of issuance.

Signed: +Mrs Donald C. Williams

Improvement Permit by: STEVE HEDRICK date 6/24/93

Existing System Inspection by: date

Installed by: JAMES HUDLER date 7/9/93

Certificate of Completion by: STEVE HEDRICK date

Operation Permit by: date

HEALTH DEPT. COPY: WHITE INSPECTION COPY (FINAL): GREEN OWNER COPY (FINAL): YELLOW INSPECTION COPY (INITIAL): PINK OWNER COPY (INITIAL): GOLD