IREDELL COUNTY HEALTH DEPARTMENT

STATESVILLE 704-878-5305 MOORESVILLE 704-664-5281

IMPROVEMENT PERMIT / AUTHORIZATION TO CONSTRUCT / OPERATION PERMIT / EXISTING SYSTEM INSPECTION

PERMIT# 075773 PIN# 4810 747977 DATE 8-17-98

OWNER OR CONTRACTOR LESTER L. SLOAN PHONE: Business Home 876-3786

ADDRESS 185 ERNEST ROAD, STATESVILLE NC 28677

LOCATION NC 115 N, TL MTN. VIEW RD, TL NEWLAND LANE, ~0.1 MILE ON LEFT, ~340' OFF ROAD

SUBDIVISION BLOCK / SECTION LOT LOT AREA 1.000 ACRE SITE CLASS PS DESIGN FLOW 360 L.T.A.R. 0.40 GPD/FT²

Septic Tank: 1000 Gallons; STB 1012 Date 5-21-99
Pump Tank: Gallons; PT Date
Pump Make: Model Serial No.
Nitrification Field: No Fields 1 Square Feet 900 Linear Feet 300
No Lines THREE Trench Width 36" Max Trench Bottom Depth 36" Gravel Depth 12"

☑ New System ☐ Repair System Type: I, II, III, IV, V, VI
System Description: CONVENTIONAL GRAVITY
Repair System Description: CONV. GRAVITY
Maintenance Agreement Required: ☐ Yes ☐ No
☐ Slab ☑ Crawl Space ☐ Basement w/plumbing ☐ Basement wo/plumbing

☑ House/Mod. Home No. Bedrooms 2
☐ Mobile Home No. Bathrooms 1
☐ Business No. Employees
☐ Other FUTURE 3BR


Water Supply: ☑ Individual ☐ Public ☐ Community
WELL

Comments:/Conditions: ① KEEP SYSTEM MINIMUM 100' FROM WELL.
② USE SCH 80 PVC BENEATH DRIVEWAY


Comments:/Conditions:
* Note Driveway in Front of House
Tank set on side ~ 30Ft

SCALE 1"=50'

INITIAL SITE SKETCH

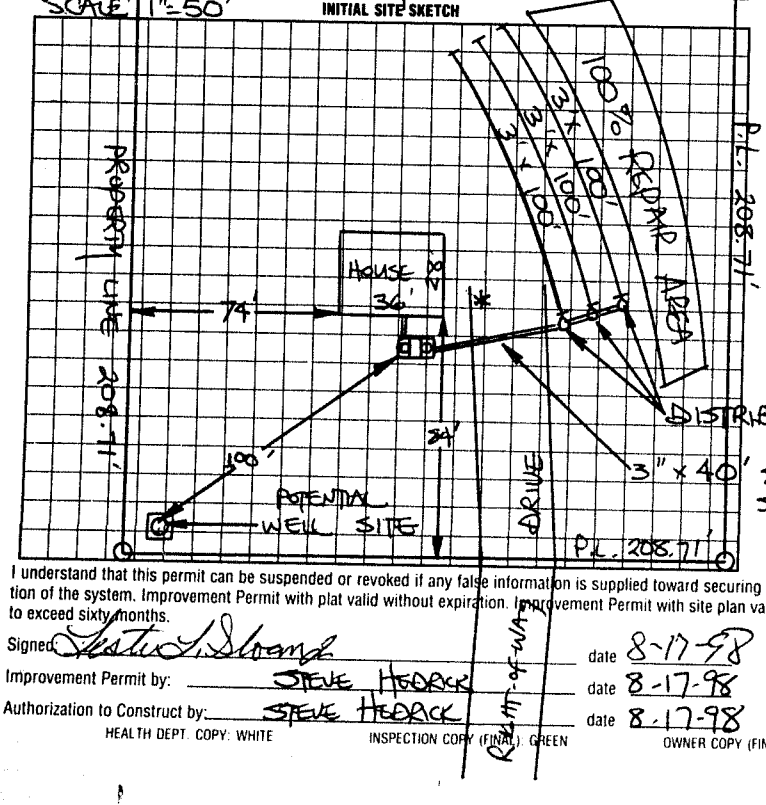

AS BUILT SKETCH

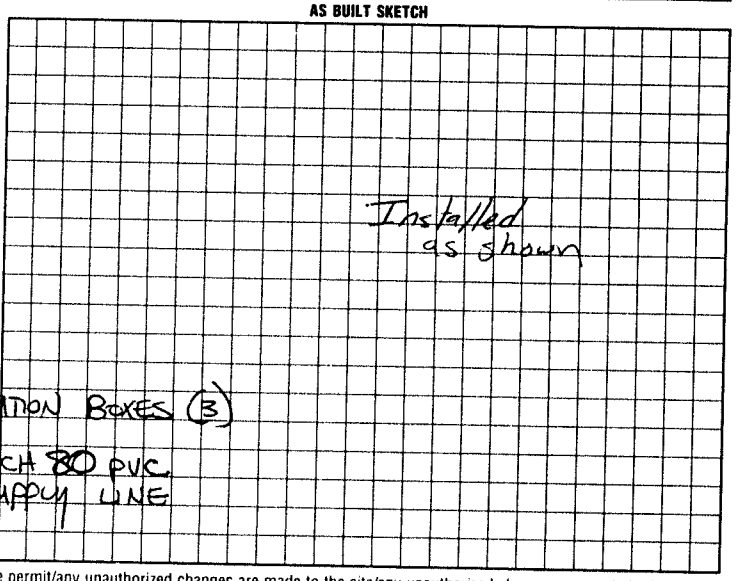

I understand that this permit can be suspended or revoked if any false information is supplied toward securing the permit/any unauthorized changes are made to the site/any unauthorized changes are made in the installation of the system. Improvement Permit with plat valid without expiration. Improvement Permit with site plan valid for sixty months. Authorization to Construct is valid for a period equal to that of Improvement Permit – not to exceed sixty months.

Signed: Lester L Sloan Jr date 8-17-98

Improvement Permit by: STEVE HEDRICK date 8-17-98

Authorization to Construct by: STEVE HEDRICK date 8-17-98

Installed by: C+W

Operation Permit by: Mary C Owens RS date 7-28-99

Existing System Inspection by: date

HEALTH DEPT. COPY: WHITE INSPECTION COPY (FINAL): GREEN OWNER COPY (FINAL): YELLOW INSPECTION COPY (INITIAL): PINK OWNER COPY (INITIAL): GOLD