Permit # 20137b

Perry Harrington

IREDELL COUNTY HEALTH DEPARTMENT

STATESVILLE 704-878-5305 MOORESVILLE 704-664-5281

IMPROVEMENT PERMIT / AUTHORIZATION TO CONSTRUCT / OPERATION PERMIT / EXISTING SYSTEM INSPECTION

PERMIT# 075773 PIN# 4810 74 7977 DATE 8-17-98

OWNER OR CONTRACTOR LESTER L. SLOAN PHONE: Business Home 876-3786

ADDRESS 185 ERNEST ROAD, STATESVILLE, NC 28677

LOCATION NC 115 N, TL MTN. VIEW RD, TL NEWLAND LAKE, ~0.1 MILE on LEFT ~340' OFF ROAD

SUBDIVISION BLOCK / SECTION LOT LOT AREA 1.000 Acre SITE CLASS. PS DESIGN FLOW 360 L.T.A.R. 0.40 gpd/ft²

Septic Tank: 1000 Gallons; STB 1012 Date 5-21-98

Pump Tank: Gallons; PT Date

Pump Make: Model Serial No.

Nitrification Field: No Fields 1 Square Feet 900 Linear Feet 300

No Lines THREE Trench Width 36" Max Trench Bottom Depth 36"

☒ New System ☐ Repair System Type: I II III IV V VI

System Description: CONVENTIONAL GRAVITY

Repair System Description:

Maintenance Agreement Required: ☐ Yes ☐ No

Gravel Depth 12" ☐ Slab ☒ Crawl Space ☐ Basement w/plumbing ☐ Basement w/o plumbing

☒ House/Mod. Home No. Bedrooms 2

☐ Mobile Home No. Bathrooms 1

☐ Business No. Employees


☐ Other FUTURE 3 BR

Water Supply: ☒ Individual ☐ Public ☐ Community WELL


Comments/Conditions: ① KEEP SYSTEM MINIMUM 100' FROM WELL.
② USE SCH 80 PVC BENEATH DRIVEWAY

Comments/Conditions: * Note Driveway in Front of House
Tank set on side ~ 30 Ft

INITIAL SITE SKETCH

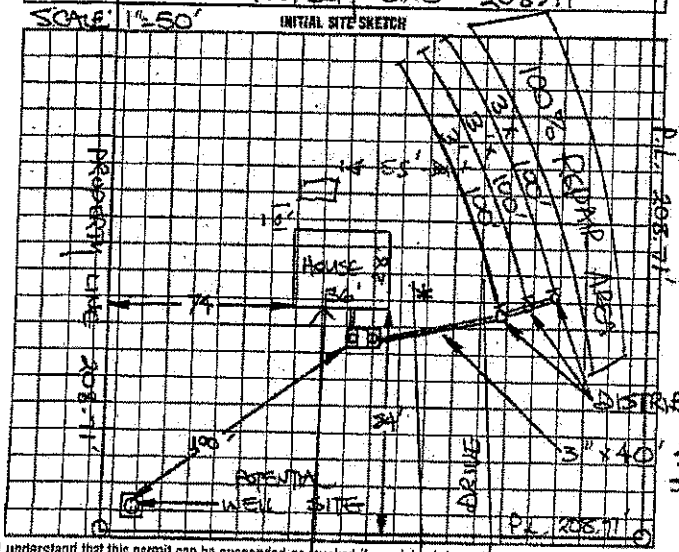

AS BUILT SKETCH

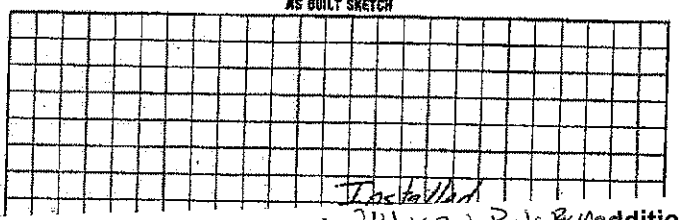

Location of the proposed 24' X 30' Pole Barn addition does not appear to impact the existing on-site septic system or well.**NOTE:

REHS Date: 1-23-14

ICHD-Environmental Health Division

I understand that this permit can be suspended or revoked if any false information is supplied toward securing the permit/any unauthorized changes are made to the site/any unauthorized changes are made in the installation of the system. Improvement Permit with plat valid without expiration. Improvement Permit with site plan valid for sixty months. Authorization to Construct is valid for a period equal to that of Improvement Permit – not to exceed sixty months.

Signed: date 8-17-98

Improvement Permit by: STEVE HEDRICK date 8-17-98

Authorization to Construct by: STEVE HEDRICK date 8-17-98


HEALTH DEPT. COPY: WHITE INSPECTION COPY (FINAL): GREEN OWNER COPY (FINAL): YELLOW

Installed by: C&W

Operation Permit by: date 7-28-99

Existing System Inspection by: date

INSPECTION COPY (INITIAL): PINK OWNER COPY (INITIAL): GOLD

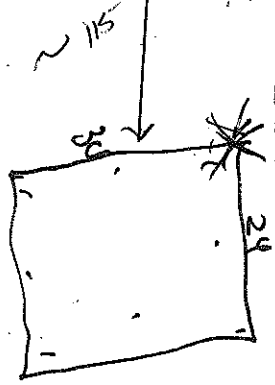

Location of the proposed 12'x25' POOL addition does not appear to impact the existing on-site septic system.**NOTE: KEEP POOL MIN. 15' FROM SYSTEM

R. STEVE HEDRICK REHS

Date: APRIL 2 2012

ICHD-Environmental Health Division