IREDELL COUNTY HEALTH DEPARTMENT

Statesville Office (704) 878-5305 Mooresville Office (704) 660-3625 PERMIT # 208581

IMPROVEMENT PERMIT / AUTHORIZATION TO CONSTRUCT / OPERATION PERMIT / EXISTING SYSTEM

PIN # 4810840953

APPLICANT: Perry Harrington APPLICANT ADDRESS: 119 Newland Ln.

SITE ADDRESS: 119 Newland Ln. PHONE: 704-682-6804 ALT. PHONE: N/A

SITE DIRECTIONS: Hwy 115 N TL Mountain View Rd TL Newland Ln. 2nd Drive on left

SUBDIVISION: Betty S Sloan Property SECTION: N/A LOT # 1 LOT AREA: 2.10 acres DESIGN FLOW: 360gpd L.T.A.R.: Existing


Septic Tank	Existing (gal)	STB		Date		☐ New System ☐ Repair ☐ Expansion	System Type: I (II) III IV V VI	☑ Residence	No. Bedrooms 3
Pump Tank	(gal)	PT		Date		System Description:	Conventional	☐ Business	No. Persons 6
Pump Make		Model		Serial #		Repair System Description:		☐ Other	No. Employees
# Nitrification Fields	Ex	# Lines	Ex	Linear Ft:	Ex	Maintenance Agreement Required:	☐ YES ☑ NO	☐ Slab	☑ Crawl Space
Trench Width	Ex	Max. Trench Bottom Depth	Ex	Gravel Depth	Ex	☑ GRAVITY	☐ PRESSURE	☐ Basement w/plumbing	☐ Basement w/o plumbing

Water Supply: ☑ Private ☐ Public ☐ Community


Comments / Conditions:

- Maintain a minimum of 5' between all building foundations & all components of septic tank system.

INITIAL SITE SKETCH

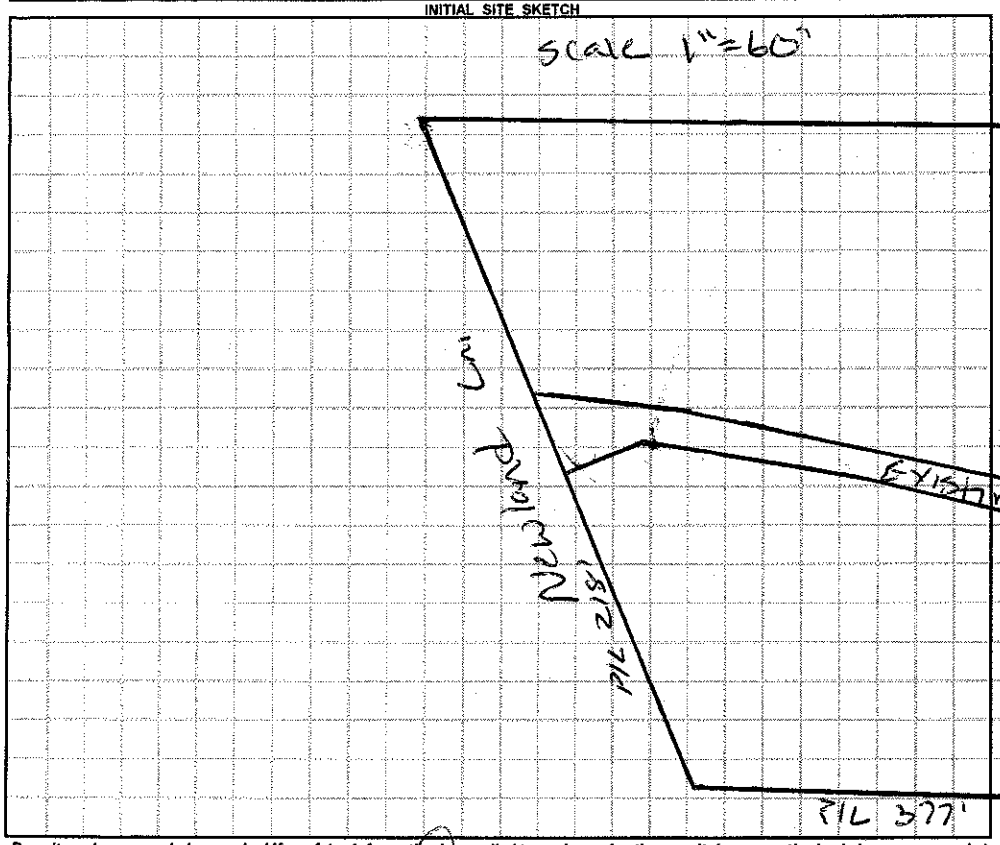

AS BUILT SKETCH

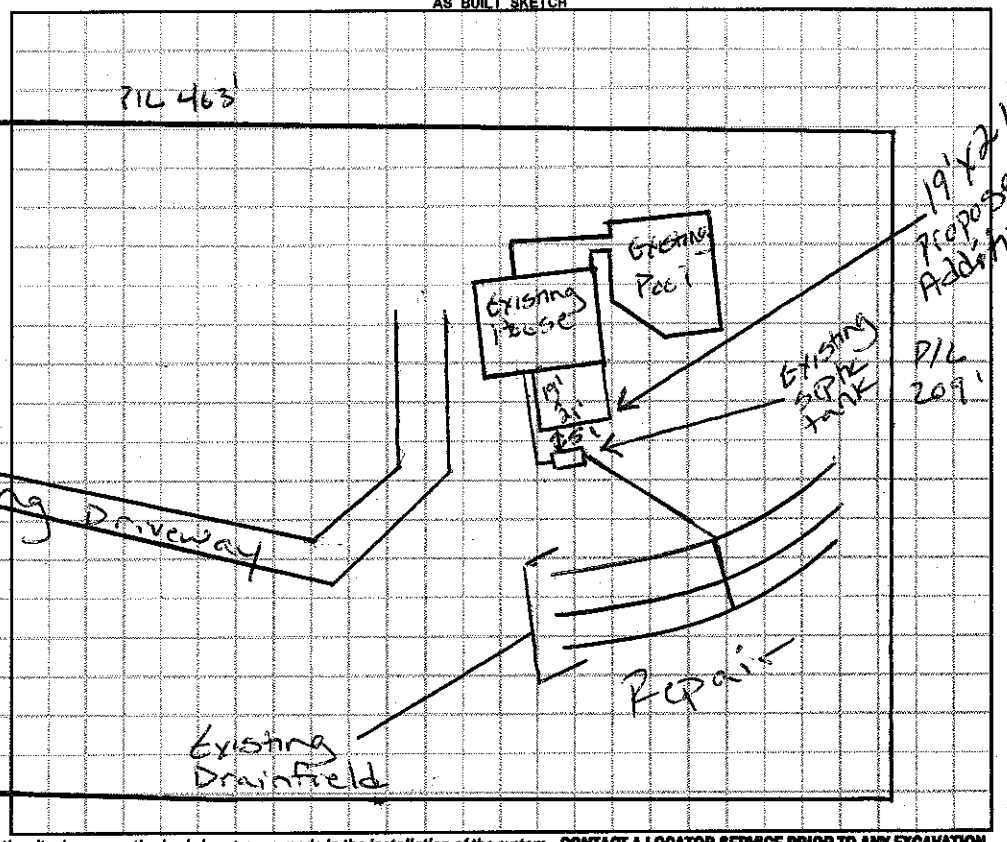

Permit can be suspended or revoked if any false information is supplied toward securing the permit / any unauthorized changes are made to the site / any unauthorized changes are made in the installation of the system. **CONTACT A LOCATOR SERVICE PRIOR TO ANY EXCAVATION**

☐ **IMPROVEMENT PERMIT** *with plat valid without expiration* ☐ **IMPROVEMENT PERMIT** *with site plan valid for 60 mos.* ☐ **AUTHORIZATION TO CONSTRUCT** *valid for period equal to IMPROVEMENT PERMIT--not to exceed 60 mo.*

Owner / Applicant Signature: [signature] Date: 3-12-20 Installed by:

IMPROVEMENT PERMIT by: Date: OPERATION PERMIT by: Date:

AUTHORIZATION TO CONSTRUCT by: Date: Existing System Inspected by: Justin Mendenhall Date:

Health Dept. Copy - WHITE Applicant (Final Approval) - YELLOW Applicant (Conditional Approval) - PINK