This drawing replaces permit issued 10-16-09 (ad)

IREDELL COUNTY HEALTH DEPARTMENT

STATESVILLE 704-878-5305 MOORESVILLE 704-664-5281

IMPROVEMENT PERMIT / AUTHORIZATION TO CONSTRUCT / OPERATION PERMIT / EXISTING SYSTEM INSPECTION

PERMIT # 158658 PIN # 4810-84-3840 DATE 10-19-09

OWNER or APPLICANT Michael Sloan PHONE: Business 704 876 2881 Home:

OWNER or APPLICANT ADDRESS 173 Mountainview

LOCATION / DIRECTIONS 115N, (L) on Mountainview, (L) on Newland, 1st drive on left

SUBDIVISION n/a BLOCK / SECTION LOT # LOT AREA 8.48 Ac. DESIGN FLOW 360 L.T.A.R. .3

Septic Tank 1000 Gallons: STB 1007 Date 9-20-02

Pump Tank Gallons: P T Date

Pump Make Model Serial #

Nitrification Field No Fields 1 No Lines 3 Linear Feet 400

Trench Width 36" Max. Trench Bottom Depth 24" Gravel Depth 12"

☐ New System ☐ Repair ☐ Expansion System Type I II III IV V VI

System Description: Existing (Conventional Gravity)

Repair System Description: same

Maintenance Agreement Required ☐ YES ☒ NO

☒ GRAVITY ☐ PRESSURE

☒ Residence No. Bedrooms 3 ☐ Business No. Persons ☐ Other No. Employees

☐ Slab ☒ Crawl Space ☐ Basement w/plumbing ☐ Basement w/o plumbing


Water Supply: ☒ Private ☐ Public ☐ Community

Comments / Conditions

Comments / Conditions

INITIAL SITE SKETCH

AS BUILT SKETCH

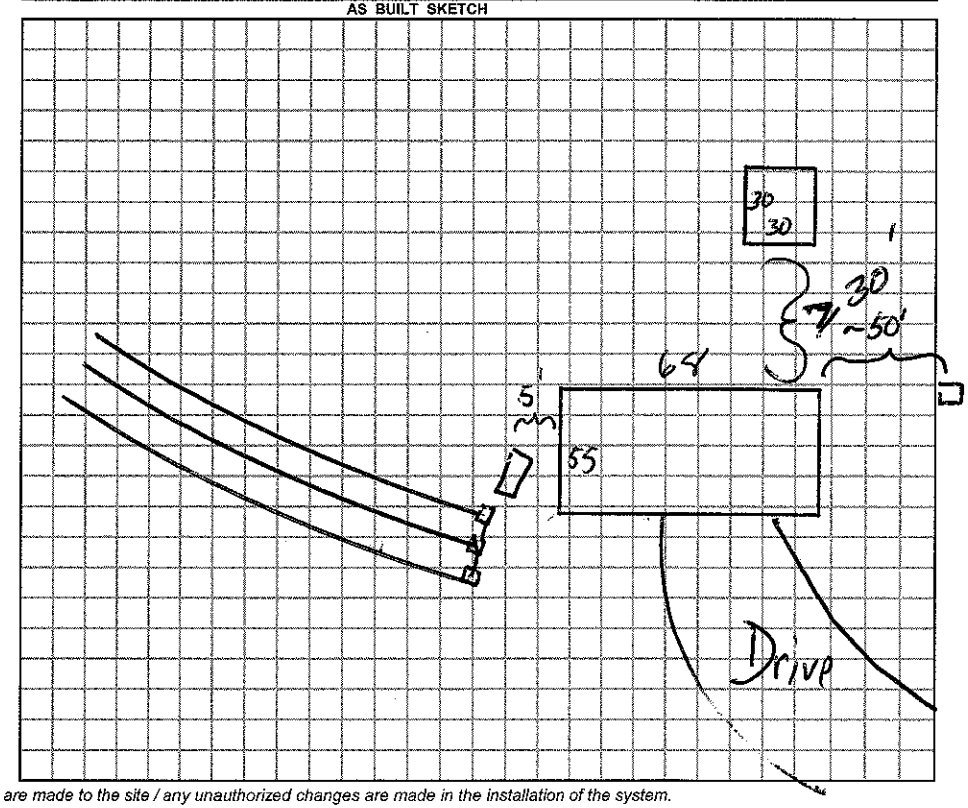

Permit can be suspended or revoked if any false information is supplied toward securing the permit / any unauthorized changes are made to the site / any unauthorized changes are made in the installation of the system.

☐ *IMPROVEMENT PERMIT w / plat valid without expiration.* ☐ *IMPROVEMENT PERMIT w / site plan valid for 60 mos.* ☐ *AUTHORIZATION TO CONSTRUCT valid for period equal to IMPROVEMENT PERMIT-not to exceed 60 mo.*

Owner / Applicant Signature: Michael Sloan Date 10/16/09

Improvement Permit by: Date

Authorization to Construct by: Date

YOU SHOULD CONTACT A LOCATOR SERVICE PRIOR TO ANY EXCAVATION.

Installed by:

Operation Permit by: Date:

Existing System Inspected by: Date: 10-19-09

WHITE COPY Environmental Health YELLOW COPY (Final) Owner / Applicant PINK COPY (Initial) Owner / Applicant