IREDELL COUNTY HEALTH DEPARTMENT

STATESVILLE 704-878-5305 (C) MOORESVILLE 704-664-5281

IMPROVEMENT PERMIT / AUTHORIZATION TO CONSTRUCT / OPERATION PERMIT / EXISTING SYSTEM INSPECTION

PERMIT# 106827 PIN# 4810-85-5811 DATE 6-14-02

OWNER OR CONTRACTOR PENNY WILLIAMS PHONE: Business 704-872-0271 Home

ADDRESS 208 MOUNTAIN VIEW ROAD STATESVILLE NC 28625

LOCATION NC 115 NORTH, TL MOUNTAIN VIEW ROAD, 3RD DRIVE ON RIGHT PAST DOBSON ROAD.

SUBDIVISION ____ BLOCK / SECTION ____ LOT ____ LOT AREA UNITED SITE CLASS PS DESIGN FLOW 480 L.T.A.R. 0.30 GPD/FT²

Septic Tank: EXISTING Gallons: STB ____ Date ____

Pump Tank: ____ Gallons: PT ____ Date ____

Pump Make: ____ Model ____ Serial No. ____

Nitrification Field: No Fields 1 Square Feet 300 Linear Feet 133

No Lines ONE Trench Width 36" Max Trench Bottom Depth 36" Gravel Depth 12"

☑ New System ☐ Repair System Type: I II III IV V VI

System Description: CONVENTIONAL, GRAVITY

Repair System Description: CONVENTIONAL, GRAVITY

Maintenance Agreement Required: ☐ Yes ☑ No

☐ Slab ☑ Crawl Space ☐ Basement w/plumbing ☐ Basement wo/plumbing

☑ House/Mod. Home No. Bedrooms 4

☐ Mobile Home No. Bathrooms ____

☐ Business No. Employees ____

☐ Other ____


Water Supply: ☐ Individual ☐ Public ☐ Community

Comments/Conditions: SEE ATTACHED EASEMENT


(3) EXPAND SYSTEM AS SHOWN BY ADDING 3' X 133' LINE AS SHOWN.

Comments/Conditions:

INITIAL SITE SKETCH

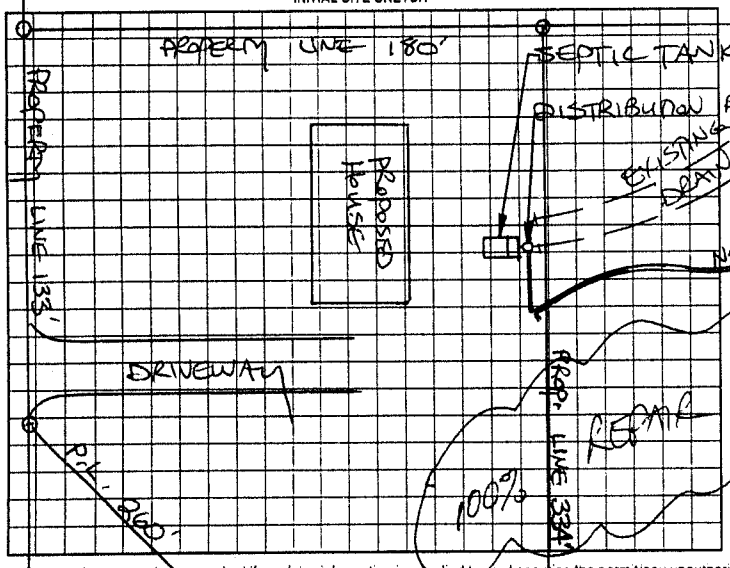

AS BUILT SKETCH

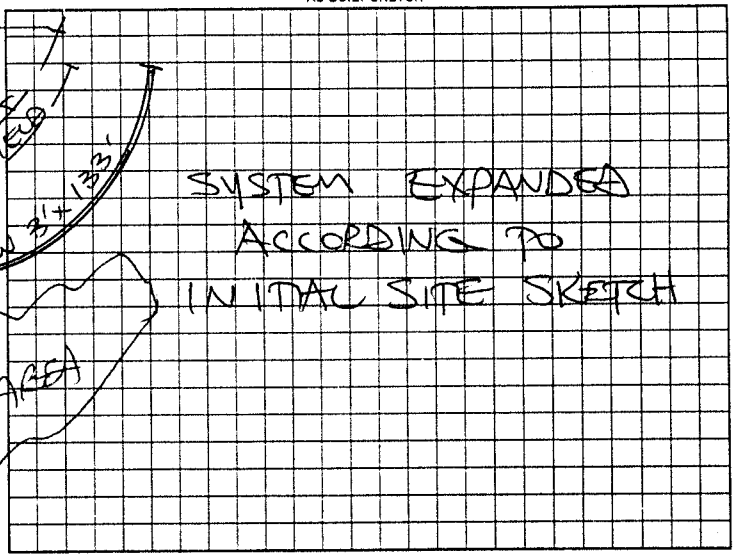

Permit can be suspended or revoked if any false information is supplied toward securing the permit/any unauthorized changes are made to the site any unauthorized changes are made in the installation of the system. Improvement Permit with plat valid without expiration. Improvement Permit with site plan valid for sixty months. Authorization to Construct is valid for a period equal to that of Improvement Permit – not to exceed sixty months

Signed: [signature] date 6-27-02 Installed by: MITCHELL GRADING

Improvement Permit by: STEVE HEDRICK date 6-14-02 Operation Permit by: STEVE HEDRICK date 7-1-02

Authorization to Construct by: STEVE HEDRICK date 6-14-02 Existing System Inspection by: ____ date ____

HEALTH DEPT COPY WHITE OWNER COPY (FINAL) YELLOW OWNER COPY (INITIAL) PINK