IREDELL COUNTY HEALTH DEPARTMENT

STATESVILLE 704-878-5305 MOORESVILLE 704-664-5281

IMPROVEMENT PERMIT / AUTHORIZATION TO CONSTRUCT / OPERATION PERMIT / EXISTING SYSTEM INSPECTION

PERMIT# 084144 PIN# 4320 00 4441 DATE 10-22-99

OWNER OR CONTRACTOR DWAYNE STROUD PHONE: Business Home

ADDRESS 2353 BUFFALO SHOALS ROAD, STATESVILLE, NC 28677

LOCATION NC 115 NORTH, TR RALPH ROAD, ~ 1600' BACK ON RIGHT

SUBDIVISION BLOCK / SECTION LOT LOT AREA SITE CLASS PS DESIGN FLOW 360 L.T.A.R. 0.20 GPD/FT²

Septic Tank: 1000 Gallons; STB 1012 Date 10-8-99

Pump Tank: Gallons; PT Date

Pump Make: Model Serial No.

Nitrification Field: No Fields 1 Square Feet 800 Linear Feet 450+

No Lines SIX Trench Width 36" Max Trench Bottom Depth 36" Depth SAND 6"

☑ New System ☐ Repair System Type: I, II, III, IV, V, VI

System Description: 25% REDUCTION GRAVITY

Repair System Description: 25% REDUCTION GRAVITY

Maintenance Agreement Required: ☐ Yes ☑ No

☑ House/Mod. Home No. Bedrooms 3

☐ Mobile Home No. Bathrooms 2

☐ Business No. Employees

☐ Other

☐ Slab ☑ Crawl Space ☐ Basement w/plumbing ☐ Basement wo/plumbing


Water Supply: ☑ Individual ☐ Public ☐ Community WELL

Comments/Conditions: ① INSTALL 25% REDUCTION SYSTEM USING 75 CHAMBERS OR 45 HDS SECTIONS ON CONTOUR AS FLAGGED ② INSTALL SUBSURFACE INTERCEPT DRAINAGE DITCH AS SHOWN BEGINNING 48" DEEP OUT TO DAYLIGHT

Comments/Conditions: SEPTIC TANK WITH RISERS INSTALLED USING "POLYLOK" FILTER

SCALE: 1"=50'

INITIAL SITE SKETCH

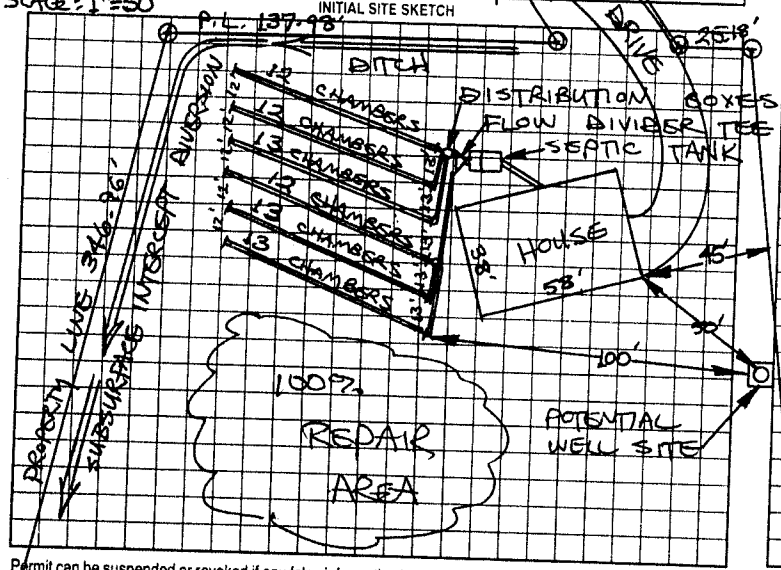

AS BUILT SKETCH

SYSTEM INSTALLED ACCORDING TO INITIAL SITE SKETCH

Permit can be suspended or revoked if any false information is supplied toward securing the permit/any unauthorized changes are made to the site/any unauthorized changes are made in the installation of the system. Improvement Permit with plat valid without expiration. Improvement Permit with site plan valid for sixty months. Authorization to Construct is valid for a period equal to that of Improvement Permit – not to exceed sixty months.

Signed: date 10-22-99

Improvement Permit by: STEVE HEDRICK date 10-22-99

Authorization to Construct by: STEVE HEDRICK date 10-22-99

Installed by: DAVID YOUNTZ

Operation Permit by: STEVE HEDRICK date 3-7-00

Existing System Inspection by: date

HEALTH DEPT. COPY WHITE OWNER COPY (FINAL) YELLOW OWNER COPY (INITIAL) PINK