IREDELL COUNTY HEALTH DEPARTMENT

Statesville Phone TR 3-7271 Mooresville Phone NO 3-1271

PERMIT TO INSTALL SEPTIC TANK

Permit No. 63 Permit Date 8 - 15 1972

Owner Henry Martin Address Statesville N C

Installed By Ray Lentz Address Statesville N C


Location of Property Hwy # 115 N 1st House on Left Past Love Valley Road

Tank		Capacity		Length of Lines		Fixtures	
Block	( )	1000	(✓)	225'	(✓)	No. of Baths	(1)
Precast	(✓)	1250	( )	250'	( )	Dishwasher	( )
		1500	( )	Other		Garbage Grdr.	( )
		Other				Other	

NOTIFY HEALTH DEPARTMENT AT LEAST EIGHT HOURS BEFORE TANK IS TO BE INSPECTED.

Final Inspection 8 - 15 1972 Approved (✓) Disapproved ( )

Remarks

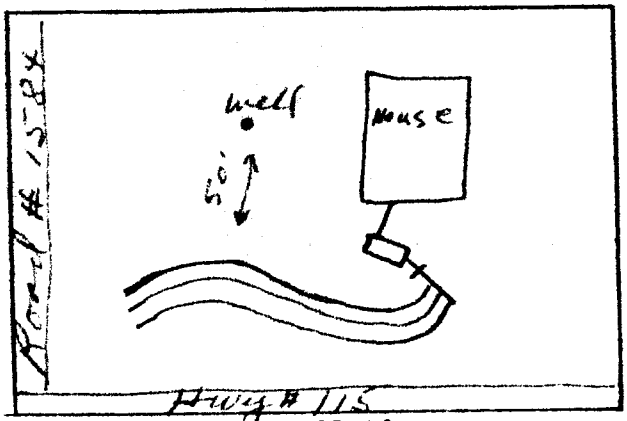

Sketch of Installation

E. G. Stevenson

Sanitarian