IREDELL COUNTY HEALTH DEPARTMENT - *ENVIRONMENTAL HEALTH* ☐ STATESVILLE OFFICE 704-878-5305 ☑ ~~☐~~ MOORESVILLE OFFICE 704-664-5281

IMPROVEMENT PERMIT / AUTHORIZATION TO CONSTRUCT ☑ / OPERATION PERMIT ☑ EXISTING SYSTEM INSPECTION

PERMIT # 167696 PIN # 4810-95-6781 DATE 17 August 2011

OWNER Bryan Shoemaker APPLICANT: Michael Sloan PHONE: Home/Cell # (704) 902-3598 Business #

SITE ADDRESS W. Iredell Hwy Statesville OWNER / APPLICANT ADDRESS

SITE DIRECTIONS 115N on Left just past Dobson Farm Rd.

SUBDIVISION BLOCK / SECTION LOT # LOT AREA 2 ac. DESIGN FLOW 360 g/d L.T.A.R. 0.3 g/ft²/d

Septic Tank 1000 Gallons: STB 1012 Date 2-17-11

Pump Tank Gallons: P T Date

Pump Make Model Serial #

No. Nitrification Fields: 1 No. Lines 4 Linear Feet 300

Trench Width 36" Max. Trench Bottom Depth 36"

☑ New System ☐ Repair ☐ Expansion System Type I II ☒ IV V VI

System Description: 25% Reduction system.

Repair System Description: 25% Reduction system.

Maintenance Agreement Required ☐ YES ☑ NO

Gravel Depth NA ☑ GRAVITY ☐ PRESSURE

☑ Residence No. Bedrooms 3

☐ Business No. Persons

☐ Other No. Employees

☐ Slab ☑ Crawl Space

☐ Basement w/plumbing ☐ Basement w/o plumbing


Water Supply: ☐ Private ☑ Public ☐ Community

Comments / Conditions Follow contours


ST has mark

Polylock Filter

INITIAL SITE SKETCH

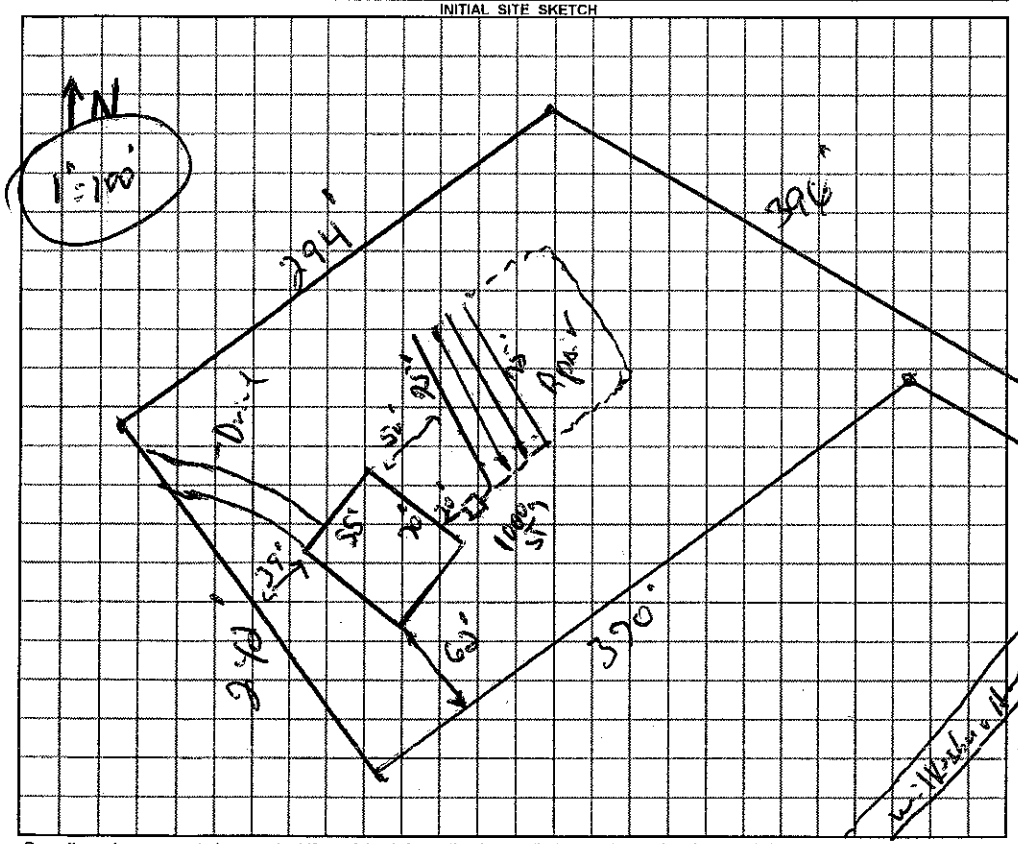

AS BUILT SKETCH

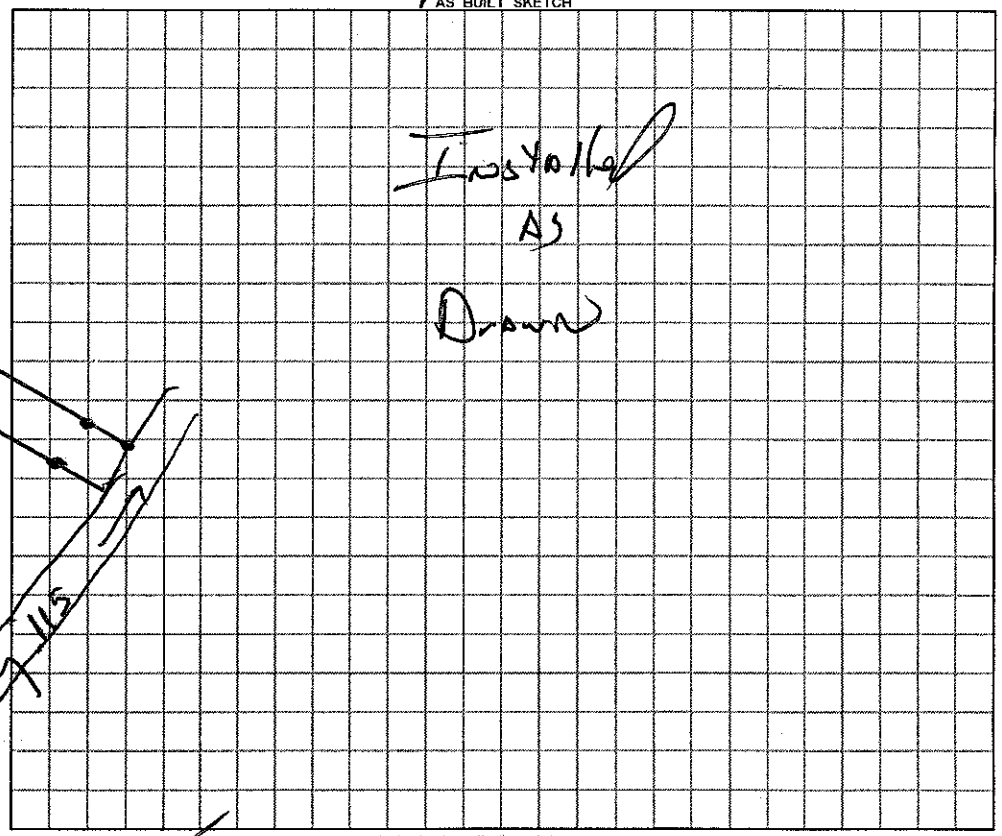

Permit can be suspended or revoked if any false information is supplied toward securing the permit / any unauthorized changes are made to the site / any unauthorized changes are made in the installation of the system.

☐ ***IMPROVEMENT PERMIT*** *with plat valid without expiration.* ☑ ***IMPROVEMENT PERMIT*** *with ~~plat valid without expiration.~~ site plan valid 60 mo.* ☑ ***AUTHORIZATION TO CONSTRUCT*** valid for period equal to IMPROVEMENT PERMIT--not to exceed 60 mo.

Owner / Applicant Signature: Date 8-18-11 Installed by: Ground Breakers

IMPROVEMENT PERMIT by: REHS Date 17 August 11 OPERATION PERMIT by: REHS Date 20 Jan. 12

AUTHORIZATION TO CONSTRUCT by: REHS Date 17 August 11 Existing System Inspected by: REHS Date

YOU SHOULD CONTACT A LOCATOR SERVICE PRIOR TO ANY EXCAVATION

White Copy – Environmental Health YELLOW COPY (Final) Owner / Applicant PINK COPY (Initial) Owner / Applicant