IREDELL COUNTY HEALTH DEPARTMENT

2-13-09 ok

STATESVILLE 704-878-5305 MOORESVILLE 704-664-5281

IMPROVEMENT PERMIT / AUTHORIZATION TO CONSTRUCT / OPERATION PERMIT / EXISTING SYSTEM INSPECTION

PERMIT # 154327 PIN # 4811-00-~~9479~~ 5378 DATE 9 February 09

OWNER or APPLICANT Dina Marlowe PHONE: Business (704) 592-9921 Home:

OWNER or APPLICANT ADDRESS 215 Shoemaker Farm Rd. Statesville, N.C.

LOCATION / DIRECTIONS 115 N TL Mountain View TL Second paved Rd. TL Shoemaker - Prop on left. In curve.

SUBDIVISION BLOCK / SECTION LOT # 1 LOT AREA 1.5 ac. DESIGN FLOW 360 g/d L.T.A.R. 0.3 g/d/Ft

Septic Tank 1000 Gallons: STB 760 Date 9-19-08

Pump Tank Gallons: P.T. Date

Pump Make Model Serial #

Nitrification Field No Fields 1 No Lines 3 Linear Feet 300

Trench Width 36" Max. Trench Bottom Depth 30" Gravel Depth N/A ☑ GRAVITY ☐ PRESSURE

☑ New System ☐ Repair ☐ Expansion System Type I II (III) IV V VI

System Description: 25% Reduction

Repair System Description: 25% Reduction

Maintenance Agreement Required ☐ YES ☑ NO

☑ Residence No. Bedrooms 3

☐ Business No. Persons

☐ Other No. Employees

☐ Slab ☑ Crawl Space

☐ Basement w/plumbing ☐ Basement w/o plumbing

Water Supply: ☑ Private ☐ Public ☐ Community


Comments / Conditions Keep 100' from existing well. Follow contour

Comments / Conditions Filter installed

INITIAL SITE SKETCH

* Please see attached site sketch.

AS BUILT SKETCH

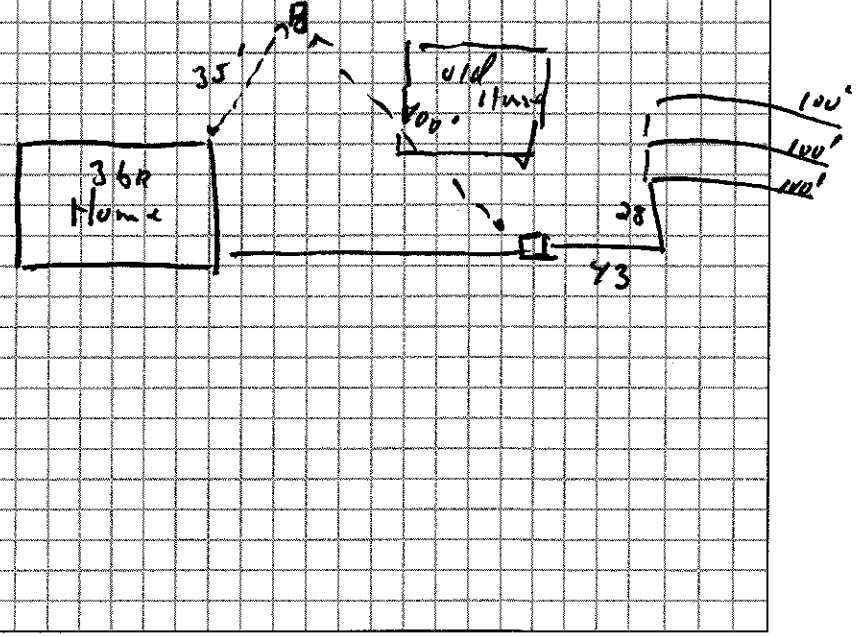

Permit can be suspended or revoked if any false information is supplied toward securing the permit / any unauthorized changes are made to the site / any unauthorized changes are made in the installation of the system.

☐ *IMPROVEMENT PERMIT w / plat valid without expiration* ☑ *IMPROVEMENT PERMIT w / site plan valid for 60 mos.* ☑ *AUTHORIZATION TO CONSTRUCT valid for period equal to IMPROVEMENT PERMIT-not to exceed 60 mo.*

Owner / Applicant Signature: Date 2-13-09

Improvement Permit by: , R.S. Date 9 Feb. 09

Authorzation to Construct by: , R.S. Date 9 Feb. 09

YOU SHOULD CONTACT A LOCATOR SERVICE PRIOR TO ANY EXCAVATION.

Installed by: Abee

Operation Permit by: , R.S. Date: 11 March 09

Existing System Inspected by: Date:

WHITE COPY Environmental Health YELLOW COPY (Final) Owner / Applicant PINK COPY (Initial) Owner / Applicant