ICHD - ENVIRONMENTAL HEALTH DIVISION

Statesville Office (704) 878-5305 (BLW) Mooresville Office (704) 660-3625

PERMIT # 31639

SEPTIC: IMPROVEMENT PERMIT / AUTHORIZATION TO CONSTRUCT / OPERATION PERMIT / EXISTING SYSTEM

PIN # 4811 - 01 - 1096

APPLICANT/OWNER: Adam Cossteverns

APPLICANT ADDRESS: 2026 Northside Drive Statesville NC 28625

SITE ADDRESS: 173 Shoemaker Farm Rd Statesville NC 28625

PHONE: 7049291552 ALT. PHONE 704-880-5356

SITE DIRECTIONS: 115 N to Mountain View Ln Shoemaker Farm. House on L

SAP CONTROLLED: ☐ YES ☐ NO

SUBDIVISION: -

SECTION: - LOT # - LOT AREA: 21.3 Acre


DESIGN FLOW: Ex L.T.A.R.: Ex

Septic Tank	(gal)	STB	Date	☐ New System	☐ Repair	☐ Expansion	System Type:	I II III IV V VI	
Pump Tank	(gal)	PT	Date	System Description:					
Pump Make	Model		Serial #	Repair System Description:					
# Nitrification Fields	#Lines		Linear Ft	Maintenance Agreement Required:	☐ YES	☐ NO			
Trench Width	Trench Bottom Depth(Low side)		Gravel Depth		☐ GRAVITY	☐ PRESSURE			

☒ Residence	No. Bedrooms	Ex	**Water Supply**
☐ Business	No. Persons	Ex	☒ Private
☐ Other	No. Employees		☐ Public
☐ Slab	☒ Crawl Space		☐ Community
☐ Basement w/plumbing			☐ Basement w/o plumbing

Comments / Conditions: Existing System Functional at time of inspection. System Meets all Setbacks. Set House at least 5' off existing System

INITIAL SITE SKETCH

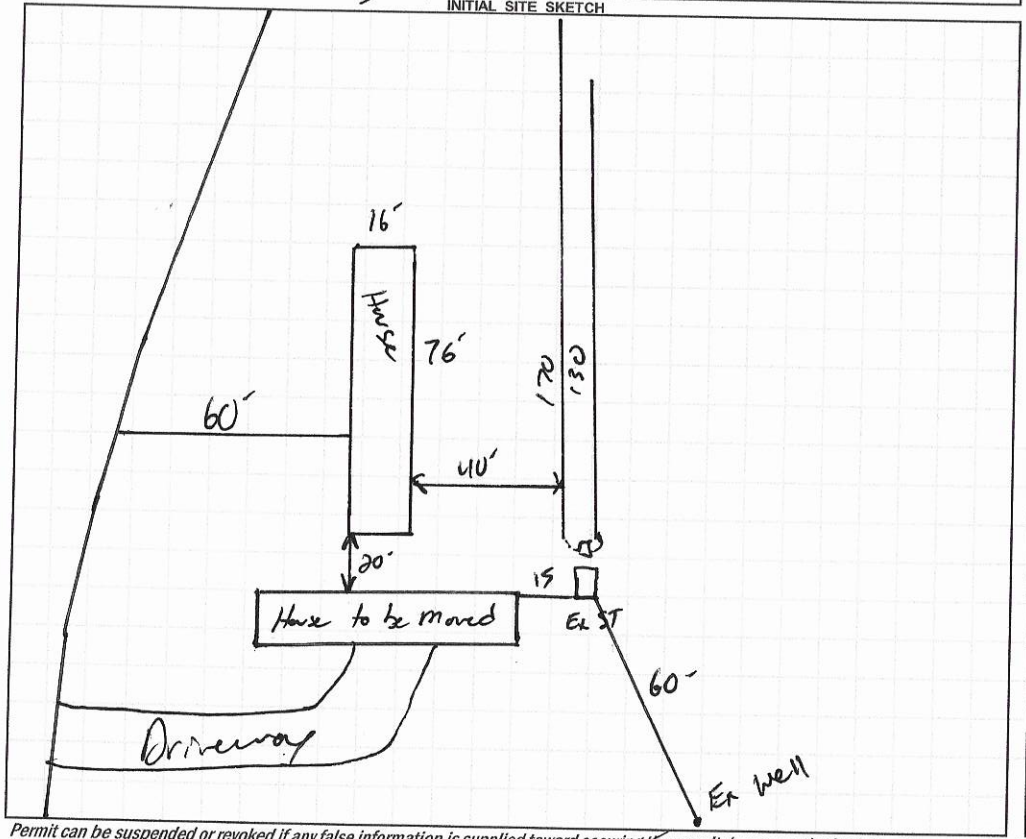

AS BUILT SKETCH

FOR SEPTIC FINAL INSPECTION CALL: 704-664-3703 between 8am-9am the day the inspection is needed. Be sure to speak with an inspector to confirm your time.

1" = 50'

Permit can be suspended or revoked if any false information is supplied toward securing the permit / any unauthorized changes are made to the site / any unauthorized changes are made in the installation of the system. **CONTACT A LOCATOR SERVICE PRIOR TO ANY EXCAVATION**

☐ **IMPROVEMENT PERMIT** *with plat valid without expiration.* ☐ **IMPROVEMENT PERMIT** *with site plan valid for 60 mos.* ☒ **AUTHORIZATION TO CONSTRUCT** *valid for period equal to IMPROVEMENT PERMIT--not to exceed 60 mo.*

Owner / Applicant Signature: [signature] Date: 11/6/20

Installed by:

IMPROVEMENT PERMIT by: Date:

OPERATION PERMIT by: Date:

AUTHORIZATION TO CONSTRUCT by: Date:

Existing System Inspected by: [signature] Date: 11-5-2020

FOR SEPTIC FINAL INSPECTION: CALL 704-664-3703 between 8am-9am the day the inspection is needed.

RECEIVED OCT 0 8 2020

APPLICATION MUST BE FILLED OUT COMPLETELY & BE LEGIBLE
OR IT WILL NOT BE PROCESSED

Iredell County Health Department – Environmental Health Division

AP-311639
$250.00

PAGE 1: *APPLICATION FORM*

Application For: ( ) New Well Permit ( ) Well Repair Permit ( ) Well Abandonment
( ) Septic Improvement Permit ( ) Authorization to Construct (X) Existing System Inspection ( ) Septic System Repair

THE ABOVE PERMIT DOCUMENTS WILL BECOME INVALID IF INFORMATION PROVIDED ON THIS APPLICATION IS FALSIFIED OR CHANGED, OR IF THE SITE IS ALTERED. THE IMPROVEMENT PERMIT IS VALID FOR EITHER 60 MONTHS OR WITHOUT EXPIRATION DEPENDING UPON DOCUMENTATION SUBMITTED. APPLICATION WITH SITE PLAN 60 MONTHS, APPLICATION WITH COMPLETE, SCALED PLAT WITHOUT EXPIRATION. SEE 15A NCAC 18A .1937(f) FOR DETAILS.

Page 2: *Site Plan Worksheet* form MUST accompany this application

The following optional attachments may also be submitted: ( ) Survey Plat, scaled no more than 1 inch = 60 feet
Place an (X) beside whichever is submitted if applicable (X) Custom Site Plan, scaled no more than 1 inch = 60 feet

Applicant Information: (PRINT CLEARLY)

Applicant Name: Adam Casstevens Address: 2026 North Side Dr Statesville Zip: 28625
Applicant Email: Adam.casstevens@claytonhomes.com Phone: 704 926 1552 Alt. Phone:
Owner Name: Sylvia Harris Address: 173 Shoemaker Rd Statesville Zip: 28625
Owner Email: Sylvia1217@yadtel.net Phone: 704-880-5356 Alt. Phone:

Property Information:

Street Address: 173 Shoemaker Farm Rd Statesville Nc 28625

Subdivision Name: Section/Phase: Lot Number:
Driving Directions: 115 N to (L) Mountain View Rd (L) @ Shoemaker Farm Rd
Home on Left

Site Development Information: *(check or complete ALL that apply*

(X) New Single Family Residence
( ) New Multi-Family Residence
( ) Accessory Building
( ) Bedroom(s) Addition
( ) Repair to failing septic system ___ Tank ___ Drain lines Describe Problem:
Maximum Number of Bedrooms: 2 w/office
Maximum Number of Occupants: 1
( ) Swimming Pool
( ) Other Addition/Structure:

CHECK FOUNDATION TYPE
(X) Crawl Space Foundation
( ) Concrete Slab Foundation
( ) Basement with Plumbing
( ) Basement without Plumbing

Non-Residential Site Development: Type of Business:
Square Footage of Building: Max. Number of Employees: Max. Number of Seats/Beds/Other:

Water Supply: ( ) Replacement Well – Reason:
( ) Multi-connection Well Number of Houses: Number of Persons:
( ) New Well (X) Existing Well ( ) Community Well ( ) City Water ( ) Other Public Water

Desired Septic System Type: *(you may rank in order of preference)* Year existing system installed: ?
( ) No Preference ( ) Alternative ( ) Conventional ( ) Innovative ( ) Modified Conventional ( ) Other:

Please answer the following to the best of your ability:
( ) Yes (X) No Does the site contain any jurisdictional wetlands?
( ) Yes (X) No Is any non-domestic sewage (i.e. industrial) to be generated?
( ) Yes (X) No Is the site subject to approval by any other public agency?

I have read this application and certify that the information provided herein is true, complete, and correct. Authorized county and state officials are granted right of entry to conduct necessary inspections to determine compliance with applicable laws and rules. I understand that I am solely responsible for the proper identification and labeling of all property lines and corners and making the site accessible so that a complete site evaluation can be performed.


Signature: Adam Casstevens 10/8/20
Property owner or owner's legal representative signature (SIGNATURE REQUIRED) DATE

IREDELL COUNTY HEALTH DEPARTMENT

ENVIRONMENTAL HEALTH DIVISION

PAGE 2: *SITE PLAN WORKSHEET*

SEE THE "SAMPLE SITE PLAN" BELOW. *INCOMPLETE SITE PLANS WILL BE RETURNED TO YOU FOR COMPLETION AND MAY RESULT IN A DELAY IN THE ISSUANCE OF YOUR SEPTIC SYSTEM PERMIT!!!*

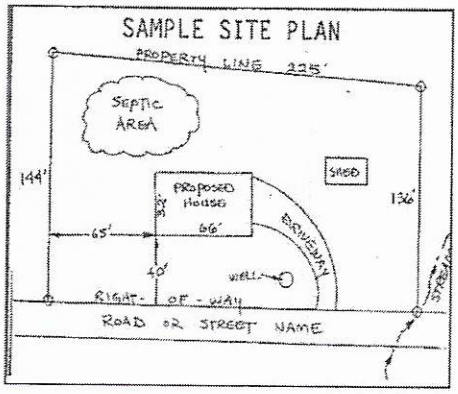

Place an (X) beside each item as you complete the site plan:

( ) Property Line measurements are clearly identified
( ) All proposed structures are indicated
( ) Front and side setbacks from property line
( ) Preferred driveway location and well location
( ) Area you prefer your septic system to be placed
( ) North arrow, or other sufficient indicator of direction

Circle N/A on the following if appropriate:

Location of septic systems and wells within 100' of your property	N/A
Location of easements and rights of ways on your property	N/A
Location of any designated wetlands on the property	N/A


USE THIS SPACE TO DRAW YOUR SITE PLAN

Show: proposed house or business footprint, wells, water lines, patios, pools and decks, and any other item that will occupy space on the site

SEE ATTACHED MAP

Signature: _____ CMH Homes _____ 10/6/20

Property owner or owner's legal representative signature (SIGNATURE REQUIRED) — DATE

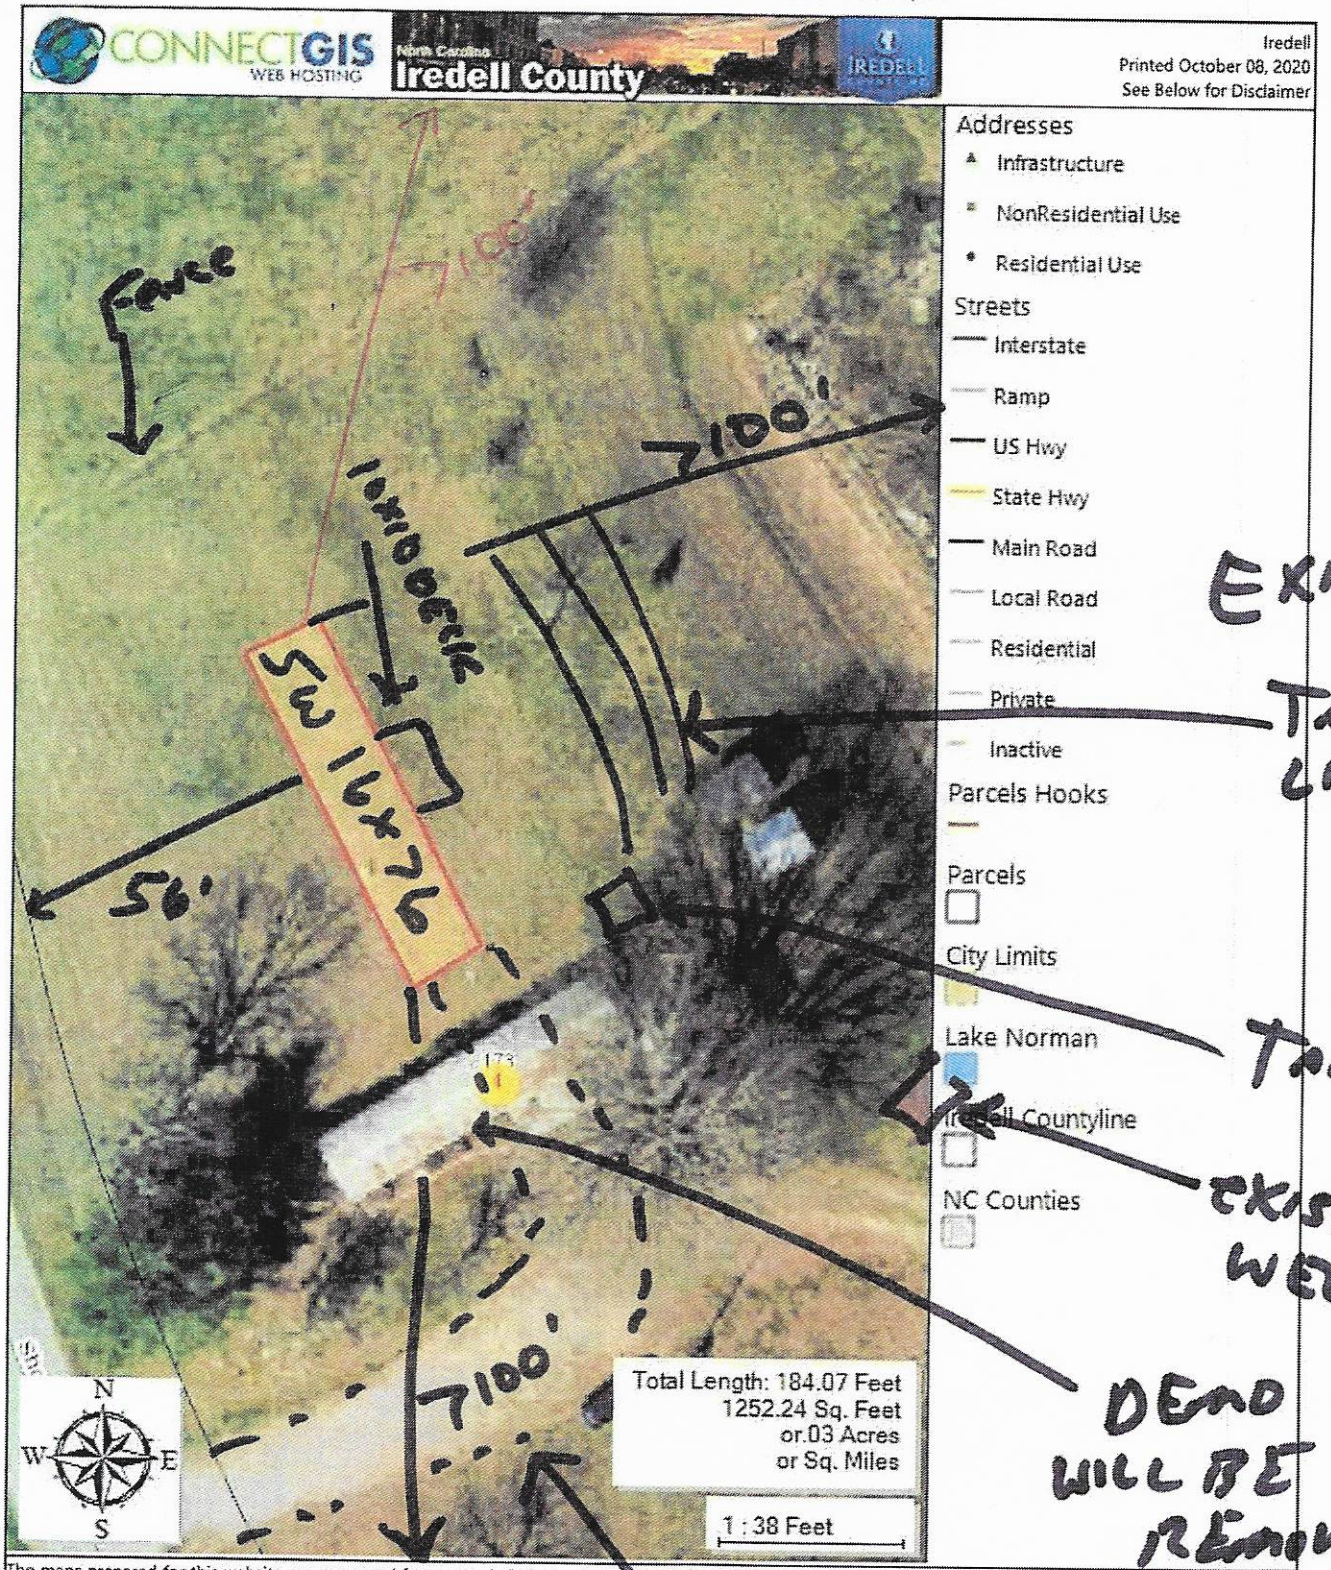

The maps prepared for this website are generated from recorded deeds, plats, and other public records. Users of these maps are hereby notified that the information provided herein should be verified. Iredell County assumes no legal responsibilities for any of the information contained on this site. Users are advised that the use of any of this information is at their own risk. All maps on this site were prepared using a "000â€™ Grid based upon the North Carolina State Plane Coordinate System from the 1983 North American Datum. The delinquent real property tax overlay is updated monthly. The information presented is not intended to be used or relied upon as official notice of tax liens. For additional information regarding delinquent taxes, contact the Iredell County Tax Collector's Office.

IREDELL COUNTY DEPARTMENT OF ENVIRONMENTAL HEALTH

DOCUMENTATION TO AUTHORIZE AN OWNER'S LEGAL REPRESENTATIVE

(Check and sign only ONE of the options below)

1. *** APPLICANT AND OWNER ARE THE SAME. *** *(Sign here)* _____

Applications for permits require the "signature of the owner or owner's legal representative" (15A NCAC 18A .1937). If the owner does not sign the application himself or herself, they can submit any one of the following documents to designate their legal representative: *Power of Attorney; Real Estate Contract; Estate executor; Bankruptcy trustee; Court ordered guardianship* In the absence of the above documentation, the property owner may provide the local health department with documentation that designates a legal representative. A property owner may:
Complete this form to document his or her legal representative, or provide his or her own form that contains the information in this form. If there are multiple property owners, then all property owners must sign the form that designates a legal representative.
By signing a form that designates a legal representative for purposes of 15A NCAC 18A .1937, the property owner authorizes that representative to act on their behalf in matters pertaining to the application and permitting process, including signing or receiving any application, document or permit. The owner retains full responsibility to meet all permit conditions specified by the local health department.

2. I, Sylvia Marlowe Harris, am the legal owner(s) of the property ~~located~~ at 123 Shoemaker Farm Rd Statesville, NC 28625 identified as

PIN (Parcel Identification Number) 4811-01-1090, located in Iredell County, North Carolina.

I do hereby authorize (**print legal representative/company name**) Clayton Homes of Statesville NC Adam Castellano, to act as an agent on my behalf in applying for/signing/obtaining any of the documents described below.

- Application for Improvement Permit (IP) / Authorization to Construct (AC)
- Improvement Permit (IP) / Authorization to Construct (AC)
- Application for soil-site evaluation (new/repair)
- Application/permit for private drinking water well/well abandonment
- Application for Compliance Inspection

I agree to abide by all decisions and/or conditions between the legal representative acting on my behalf and the Iredell County Department of Public Health, Environmental Health Division.

Sylvia Harris
Signature of Owner(s)

10-2-2020
Date

Mooresville - Environmental Health
ronda.hart@co.iredell.nc.us
Fax: 704-662-3239
610 E. Center Avenue, Mooresville, NC 28115

Statesville - Environmental Health
adrienne.shea@co.iredell.nc.us
Fax: 704-871-3483
349 N. Center Street, Statesville, NC 28677

Exhibit C"


Imperial

Sylvia Davis

8-27-2020

9-22-2020


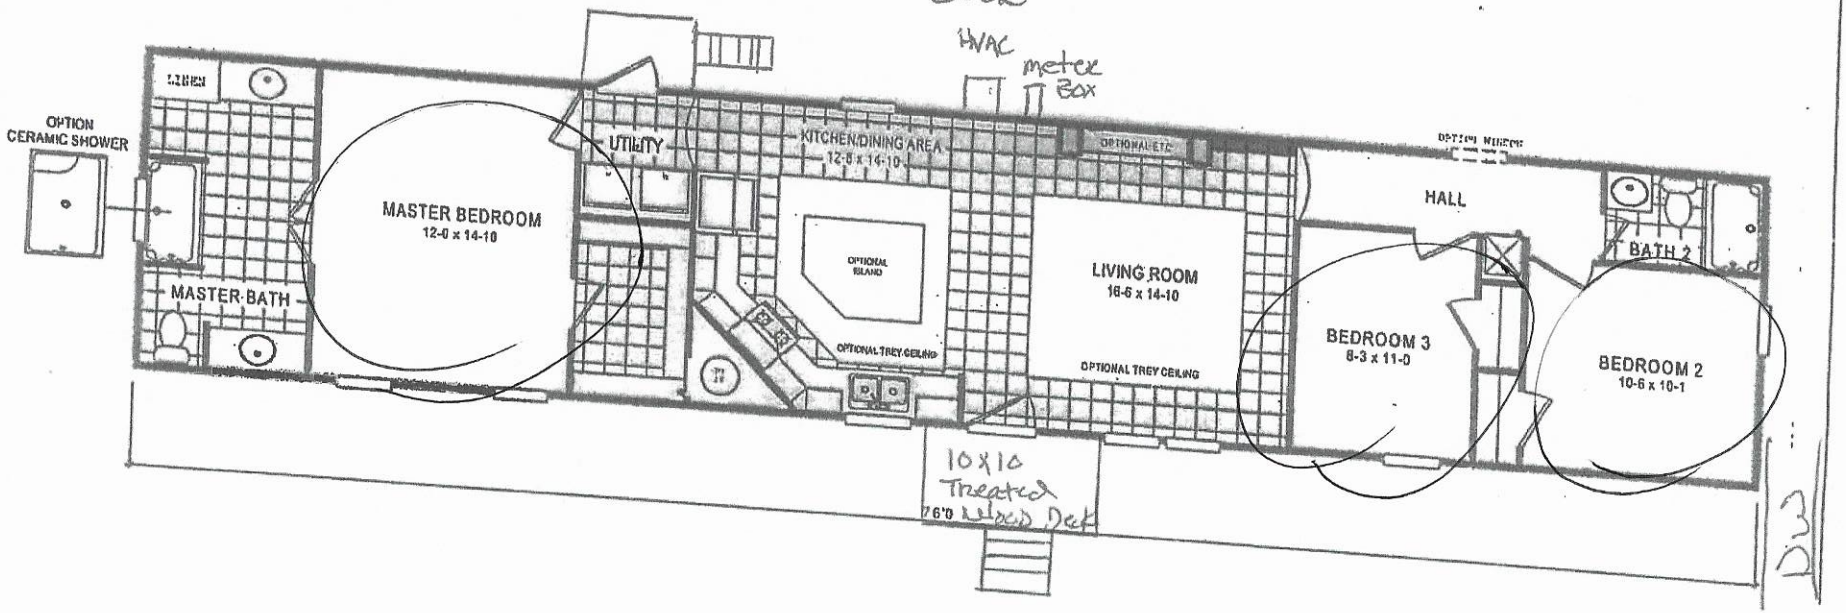

D3

IREDELL COUNTY · NC

IREDELL COUNTY
PO Box 788
349 North Center St.
Statesville, NC 28677

APPLICATION NUMBER

311639
Issue Date:

Permit Type: ZONING

Parcel Number	Street Address	Jurisdiction
4811011090.000	173 SHOEMAKER FARM RD	IREDELL COUNTY

Owner Information	Applicant Information
Name: HARRIS SYLVIA	Name: CLAYTON HOMES OF STATESVILLE
Address:	Address: 2026 NORTHSIDE DR STATESVILLE, NC 28677
Phone:	Phone: (704)873-2547

Use Requested	Zone Code
Single-Wide Mobile Home	RA

Lot Acreage	F Setback	B Setback	L Setback	R Setback	Watershed	Flood Zone
21.3	35	35	15	15	WSIV-PA Catawba/Lake Norman	NO

Remarks

REPLACE SINGLE WIDE W/NEW SINGLE WIDE

REQUIREMENTS FOR ALL SINGLEWIDE MOBILE HOMES Must meet requirement R10 of the LDC. Must remove the towing apparatus, if it cannot be removed, it shall be screened; Must have a continuous underpinning; Must have 36 square foot front porch constructed within 12 inches of the floor elevation; Must have approved steps at all other secondary entrances and exits; Must face front property line and be no less than 20 degrees from parallel to the front property line. Original home must be removed before Certificate of Occupancy can be approved.


The applicant certifies that there are no deed restrictions, contractual agreements or governmental regulations of any kind that interfere with or prohibit the use of the property or the use for which this permit is requested. The applicant further acknowledges that enforcement of deed restrictions, plat conditions and other contractual agreements will not be undertaken by Iredell County and is the sole responsibility of the affected parties.

Signature of Owner/Contractor

Date: 10/08/2020

Permit Number	311639	TOTAL FEES:	$77.25

ZONING DISCLAIMER

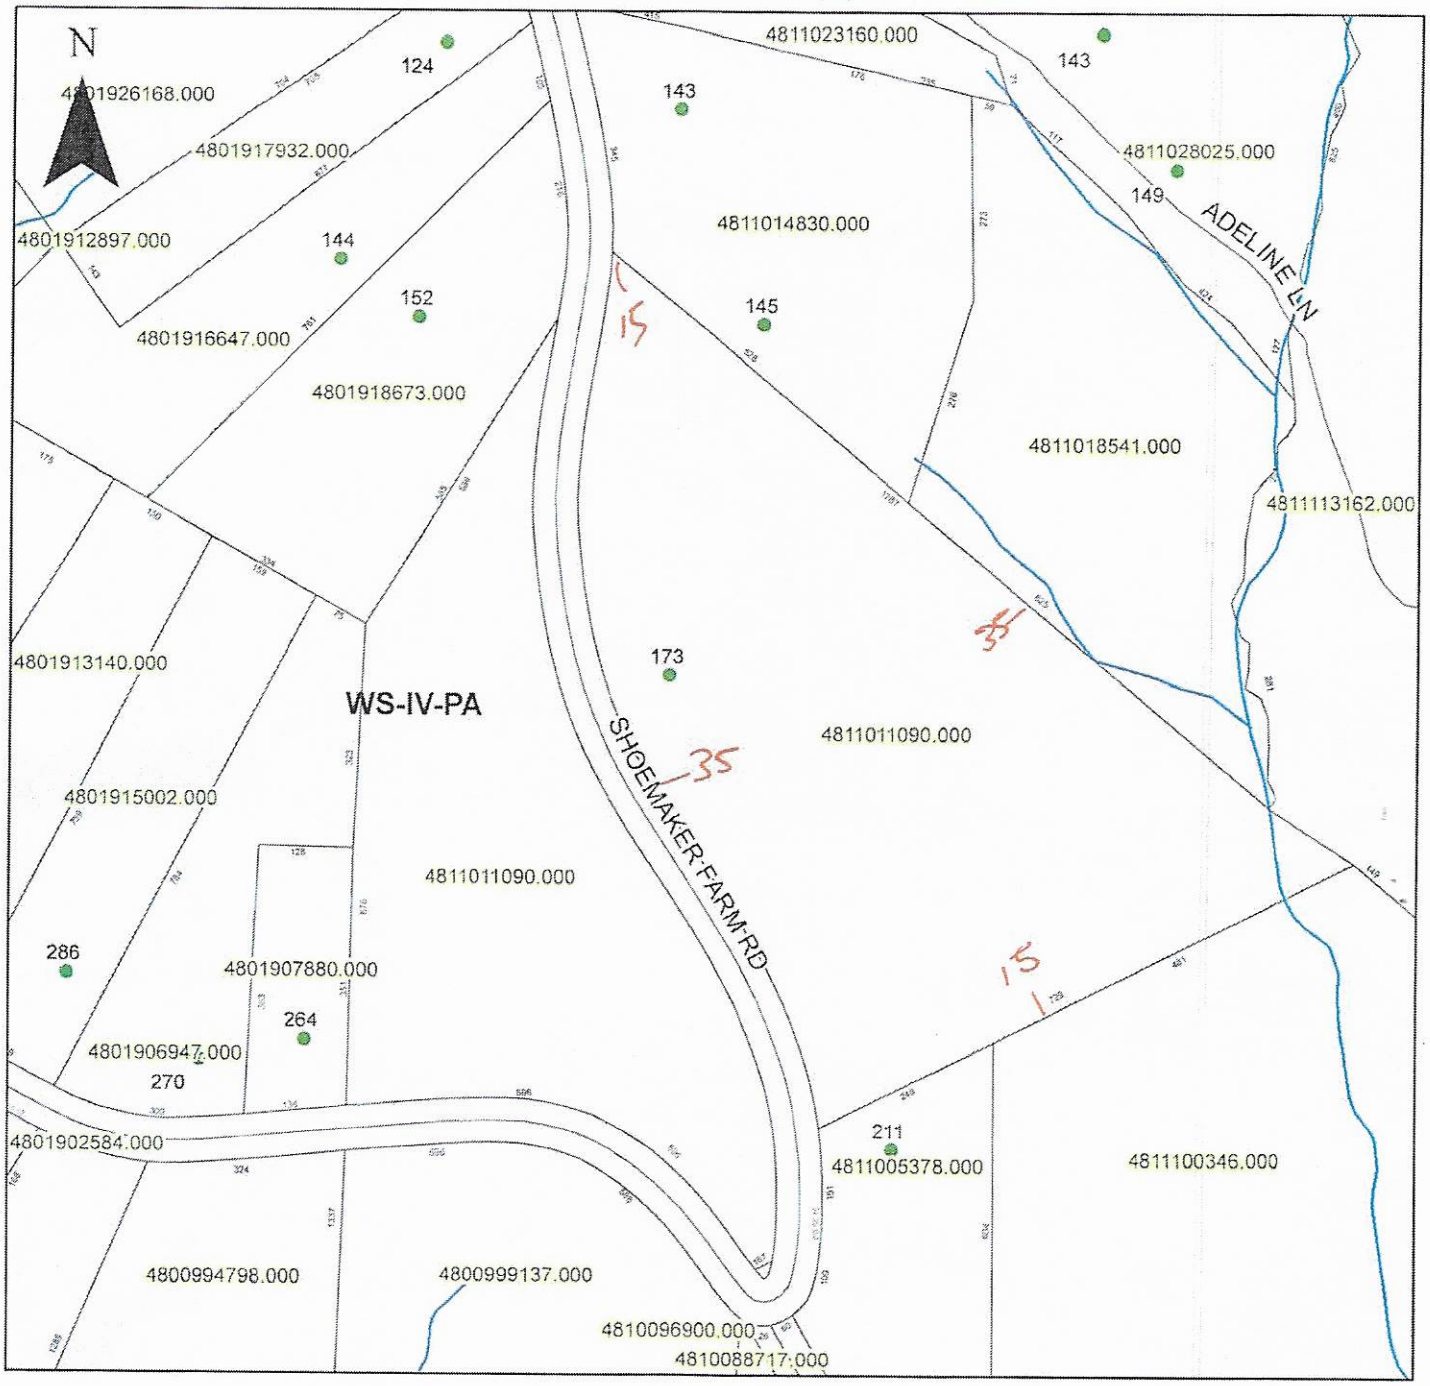

Property Address 173 Shoemaker Farm Rd.

RA 21.3 WS-IV-PA

The applicant certifies that there are no deed restrictions, contractual agreements or governmental regulations of any kind that interfere with or prohibit the use of the property or the use for which this permit is requested. Applicant further acknowledges that the enforcement of deed restrictions, plat conditions, and other contractual agreements will not be undertaken by Iredell County and is the sole responsibility of the affected parties.

Applicant

10-8-2024

Date