IREDELL COUNTY HEALTH DEPARTMENT

STATESVILLE 704-878-5305 MOORESVILLE 704-664-5281

IMPROVEMENT PERMIT / CERTIFICATE OF COMPLETION / OPERATION PERMIT / EXISTING SYSTEM INSPECTION

PROPERTY DESCRIPTION NO. 18556 DATE 5/25/94 TAX MAP NO. 15C-A-2A

OWNER OR CONTRACTOR MARY F. BLACK PHONE: Business 872-5215 Home 592-4801 Watershed: ☐ Yes ☑ No

ADDRESS RT. 2, BOX 297-A STVL, NC 28677

LOCATION NC 115 N, TL MTN. VIEW RD, TR LOVE VALLEY RD, X-CREEK, 1ST DRIVE ON (L)

SUBDIVISION BLOCK / SECTION LOT LOT AREA 5 ACRES SITE CLASS. PS DESIGN FLOW 360 L.T.A.R. 0.40 GPD/FT

Septic Tank: 1000 Gallons; STB 1012 Date 4/6/94

Pump Tank: Gallons; PT Date

Pump Make: Model Serial No.

Nitrification Field: No Fields 1 Square Feet 900 Linear Feet 300

No Lines 3 Trench Width 36" Max Trench Bottom Depth 18 ~~24~~

☑ New System ☐ Repair System Type: ☐ I ☑ II ☐ III, IV, V, VI

System Description: CONV. GRAVITY

Repair System Description: CONV. ~~GRAVITY~~ PUMP

Maintenance Agreement Required: ☐ Yes ☑ No

Gravel Depth 12"

☐ House/Mod. Home ☑ Mobile Home ☐ Business ☐ Other PLANNED FOR FUTURE

No. Bedrooms 2 No. Bathrooms 1 No. Employees


☐ Slab ☑ Crawl Space ☐ Basement w/plumbing ☐ Basement wo/plumbing

Water Supply: ☑ Individual ☐ Community ☐ Public WELL NEXT DOOR

Comments: (1) DRAINLINES TO BE INSTALLED NO DEEPER THAN 24" (2) KEEP SYSTEM MINIMUM 5' FROM MH, 10' FROM PROPERTY LINE, 50' FROM CREEK.

Comments:

INITIAL SITE SKETCH

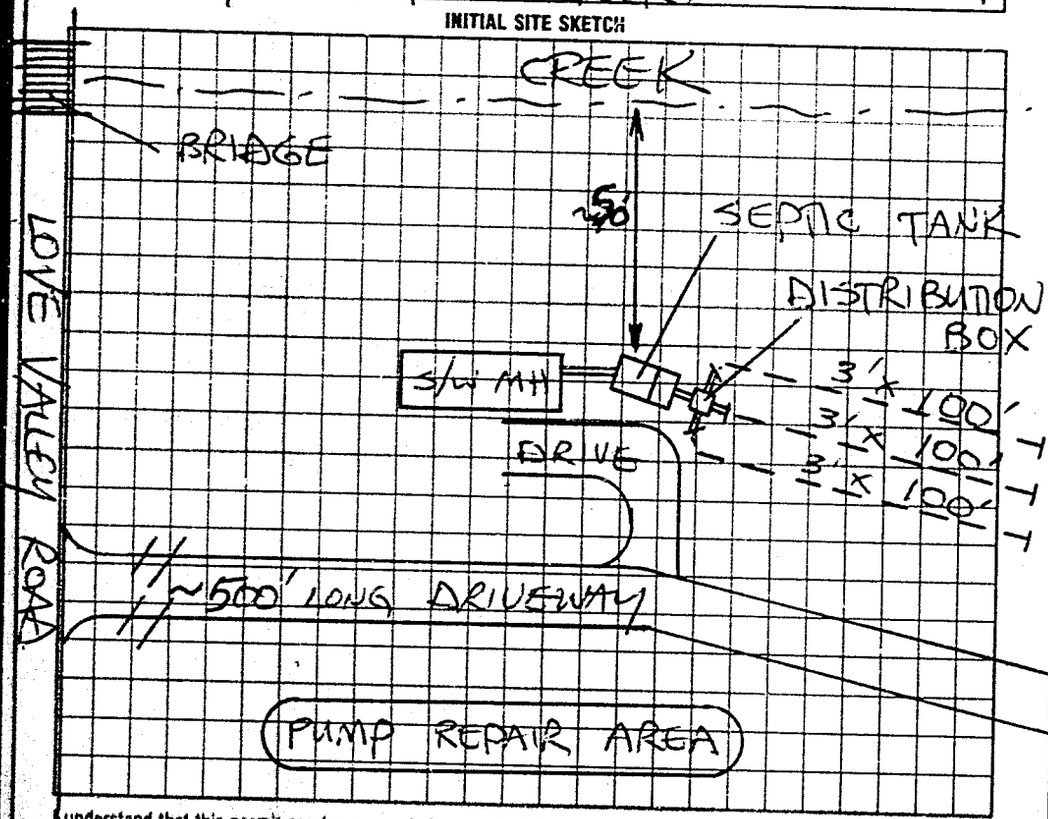

AS BUILT SKETCH

SYSTEM INSTALLED ACCORDING TO INITIAL SITE SKETCH

I understand that this permit can be suspended or revoked if any false information is supplied toward securing the permit/any unauthorized changes are made to the site/any unauthorized changes are made in the installation of the system. Improvement Permit is valid for 60 months from date of issuance.

Signed: X Mary Black

Improvement Permit by: STEVE HEDRICK date 5/25/94

Existing System Inspection by: date

Installed by: KENNY PEARSON

Certificate of Completion by: STEVE HEDRICK date 6/30/94

Operation Permit by: date

HEALTH DEPT. COPY WHITE INSPECTION COPY (FINAL) GREEN OWNER COPY (FINAL) YELLOW INSPECTION COPY (INITIAL) PINK OWNER COPY (INITIAL): GOLD